


Section 25 Township 4 Range 27W
 Well No. #4 E. B. Jennings
 Company Texas Company

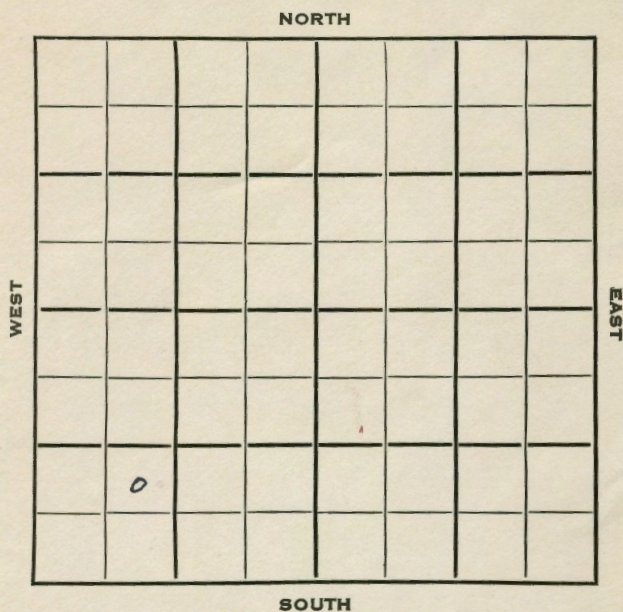


13

Sec. 25 Twp. 4 R. 27 W
 Well No. #4 E. B. Jennings Farm _____
Texas Company Company _____
Stickle Drlg. Contractor _____

_____ Ft. from N. Line
990 _____ Ft. from S. Line
 _____ Ft. from E. Line
990 _____ Ft. from W. Line

NE SW SW

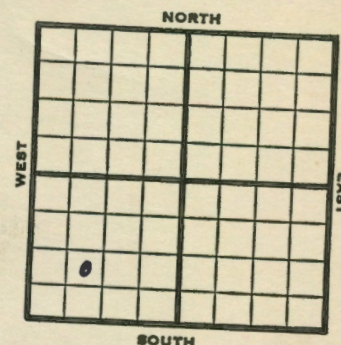

1953 Elev. 2556' REPORT

2/11 Spud 2-4-53
 10" @ 709
 Drlg. 2875'


2/20 Anhy 2054' Tarkio 3084' Top 3286'
 Heeb 3415' Lans 3456'
 TD 3570' 7" @ 3567'

2/26 DD 3571' 1 GFPH DD 3573' 500 A
 S/10 BO plus 6 BWPH 3 hrs.

3/4 Spud 2-4-53
 Oil Well
 TD 3573
 10" @ 709
 Anhy 2054, Tarkio 3084, Top 3286, Heeb 3415, Lans 3456
 TD 3570
 7" @ 3567
 DD 3571, 1 gfph
 DD 3573, 500A
 S/10 bo 6 bwph 3 hrs.
 Comp. 239 bopd 5% wtr.

COMPLETED

County Decatur State Kansas
 Sec. 25 (Blk. 4) (Sur. 27W) Map No.
 Operator Texas Company
 Well No. 4 Farm E. B. Jennings
 Elev. 2556 Location NE SW SW

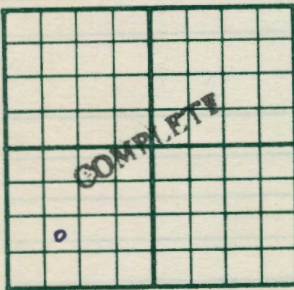


990 Ft. From S Line SW
 990 Ft. From W Line Quarter
 1st. Report
 Completion MAR 4 1953
 Remarks
Stickle Drlg. - Contr.
 Spudding Date 2-4-53

Drlg. Data Oil well TD 3573
10" @ 709 Anhy 2054 Tarkio 3084
Top. 3286 Heeb. 3415 Lans. 3456
TD 3570 7" @ 3567 DD 3571 1 gfph
DD 3573 500 A S/ 10 bo 6 bwph 3 hr.
Comp. 239 bopd 5% wtr.

J. G. McGEHEE

County Decatur State Kansas
 Sec. 25 (Blk. 4) (Sur. 27W) Map No.
 Operator Texas Company
 Well No. 4 Farm E. B. Jennings
 Elev. Location NE SW SW

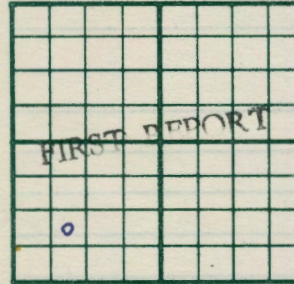

990 Ft. From S Line SW
 990 Ft. From W Line Quarter
 1st. Report FEB 11 1953
 Completion
 Remarks
Stickle Drlg. - Contr.
 Spudding Date 2-4-53

Drlg. Data
10" @ 709 drlg. 2875

J. G. McGEHEE