


Section 25 Township 4 Range 27W

Well No. #1 Mary Tacha

Company Texas Company

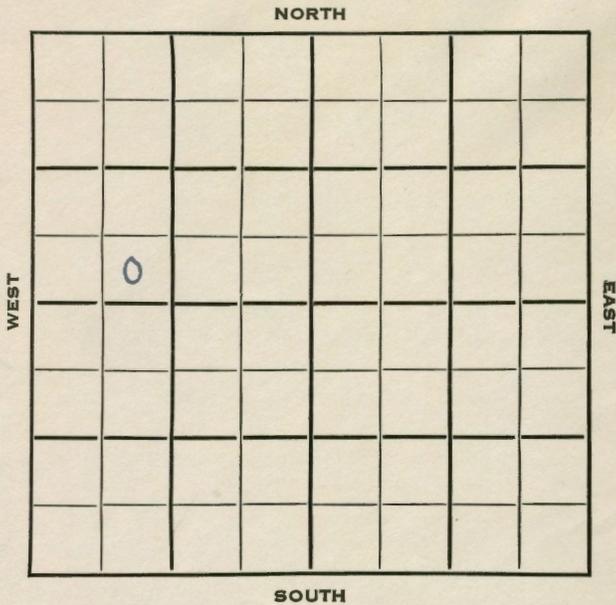

5

SEC. 25 TWP. 4 R. 27W ✓

WELL NO. 1 Mary Tacha FARM

COMPANY Texas Company

CONTRACTOR Hannum D rlg. Jennings Pool

_____ Ft. from N. Line

330 _____ Ft. from S. Line

_____ Ft. from E. Line

990 _____ Ft. from W. Line

SE SW NW

1953	ELEVATION	REPORT
	2483'	
11/4		Spud 10-30-53 10" @ 649'
11/11		Howard 3154 Top 3220 Heeb 3347 Lans 3390 RTD 3505 7" @ 3503
11/18		CO 3469 19/3156-62 16 GO & 2 GWPH 8 hrs. 2000 A S/8 BO & 1 BWPH 5 hrs. P/85 BO & 24 BW 9 hrs.
11/24		Spud 10-30-53 Oil Well TD 3505' 10" @ 649' Howard 3154', Top 3220, Heeb 3347, Lans 3390 TD 3505' 7" @ 3503' CO to 3469 19/ 3156-62 16 go 2 gwph 8 hr. 2000 A S/ 8 bo 1 bwph 5 hr. Comp 85 bopd 24 bw.

COMPLETED

