

Decatur


KANSAS

SECTION 26 TOWNSHIP 4 RANGE 27W

WELL NO. #1 Nellans Est.

COMPANY Peel Hardman Oil

NORTH

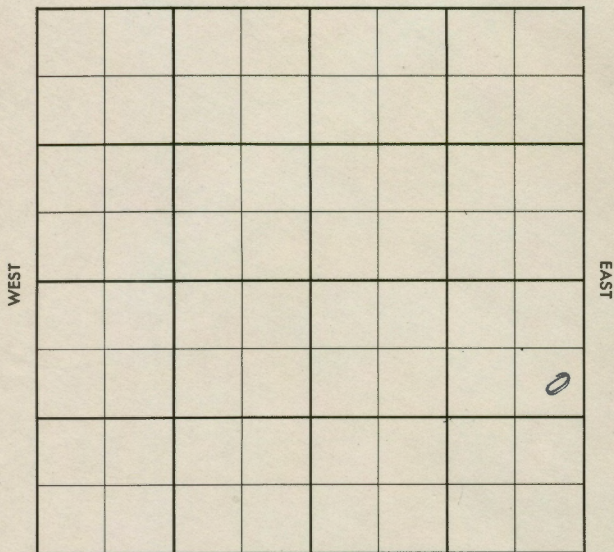

SOUTH

9

FORM 504-3 SUNRAY

SEC.

26

TWP.

4

R.

27W

WELL NO.

#1 Nellans Est

FARM

COMPANY

Peel Hardman Oil

CONTRACTOR

Co. Tools

Wildcat


FT. FROM N. LINE

FT. FROM S. LINE

FT. FROM E. LINE

FT. FROM W. LINE

NORTH

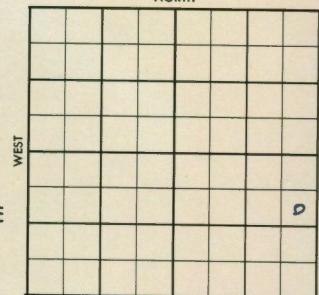

SOUTH

SE NE SE

ELEVATION

1956

REPORT

9-5

8" @ 250

FORM 504-5 SUNRAY

County Decatur Elev. _____
Sec. 26 Twp. 4 Rge. 27W
Company Peel Hardman Oil
FarmName Nellans Est. No. 1

TOPS	DEPTH	LOG	DATUM	Loc. in Sec.
Anh.				SE NE SE
Tp.				
H.				
Tr.				
Dg.				
Bl.				
L.				
K.C.				Geol.
B.K.C.				Contr.
Ce.				Co. tools
C.				
M.				
M.				Pool
K.				Wildcat
Mz.				
Me.				
V.				
S.				
S.				
A.				
R.				
Pe.				
G.				

SEP 5 '56

Date Comm. 8" @ 250

33

SEP 14 '56

DM.M

County Decatur Elev. 2507
Sec. 26 Twp. 4 Rge. 27W
Company Peel Hardman Oil
FarmName Nellans Est. No. 1

TOPS	DEPTH	LOG	DATUM	Loc. in Sec.
Anh.	<u>2205</u>			SE NE SE
Tp.	<u>3177</u>			
H.	<u>3239</u>			
Tr.	<u>3370</u>			
Dg.				
Bl.	<u>3411</u>			
L.				Geol.
K.C.				Contr.
B.K.C.				Co. tools
Ce.				
C.				
M.				Pool
M.				Wildcat
K.				
Mz.				
Me.				
V.				
S.				
S.				
A.				
R.				
Pe.				
G.				

SEP 26 '56

ABANDONED

Date Comm. 8" @ 250 SEP 12 '56 DST 3405-65
1m 60' 900 + 60' 500M BHP
60/20" 5 1/2 @ 3524 SEP 19 '56 SEP 26 '56
CO 3500 12/3496-3500 1/2 N.S.
PB 3480 16/3454-60 1 1/2 S.O.
PB 3210 PF 3180-87 550 15
\$ 3 Bwph
DEAR