


Section 36 Township 4 Range 27 W

Well No. # 1 R. L. Skubal

Company Texas Company

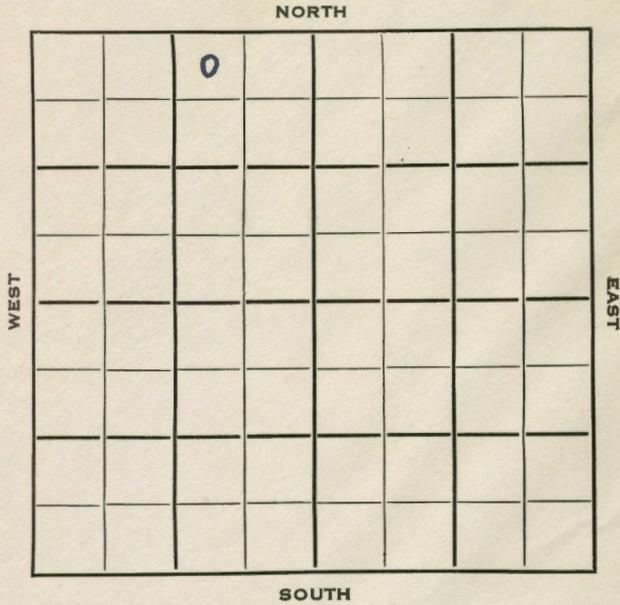

SEC. 36 TWP. 4 R. 27W **KANSAS**

WELL NO. #1 R.L. Skubal FARM

COMPANY Texas Company


CONTRACTOR Hannum Drlg. Jennings Pool

330 Ft. from N. Line

_____ Ft. from S. Line

990 Ft. from E. Line

_____ Ft. from W. Line

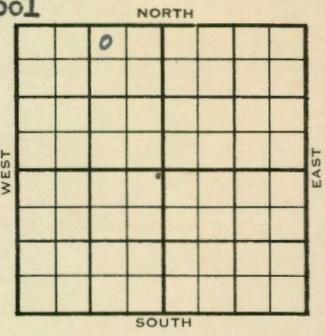

	ELEVATION	REPORT
1953	2593'	
11/18	Spud 11-15-53 Fsg. @ 708'	
12/30	Spud 11-15-53 Oil Well TD 3610' 10" @ 708' Cottonwood 2839' DST 2842'-51' opn 1 hr, rec 5' drlg m 1015# Red Eagle 2949' DST 3328'-33' opn 1 hr, rec 10' drlg mud 1098# DST 3342'-52' opn 1½ hr, rec 90' msw 1048# TD 3608' 7" @ 3607' Schlumberger Tops: Howard 3266', Top 3330', Heeb 3459', Lans 3500', CO to 3608' SSO DD 3610 1000 A S/ 18 bo 20 bw 4 hr. 2000 A S/ 26 bo 30 bw 6 hr. PB 3590 19/ 3574'-80' 1 bo 1 bwph 500 A 1 bo 1 bwph CO to 3610 S/ 1 bo 2½ bwph 4 hr. P/ 13 bo 16 bw. 12 hr. Comp 26 bopd 32 bw.	

COMPLETED

