



Section 25 Township 4 Range 27W
 Well No. #2 Keenan
 Company Texas Company

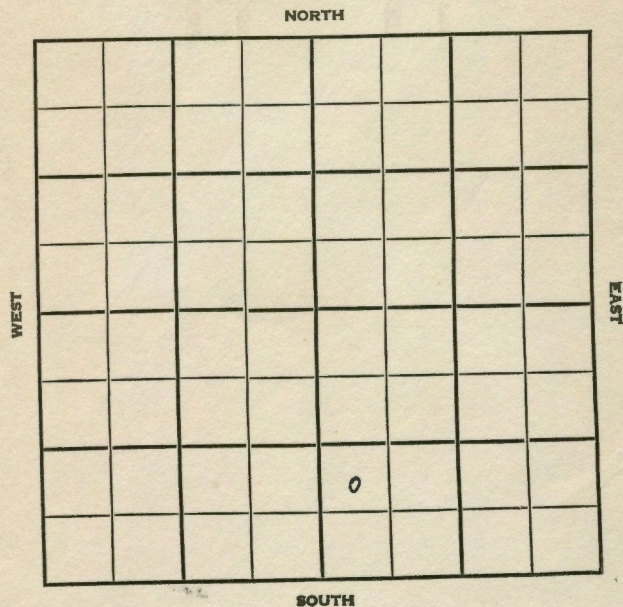

15

SEC. 25 TWP. 4 R. 27W
 WELL NO. 2 Keenan FARM
 COMPANY Texas Co.
 CONTRACTOR Powell
Jennings Pool

_____ Ft. from N. Line
990 _____ Ft. from S. Line
 _____ Ft. from E. Line
330 _____ Ft. from W. Line

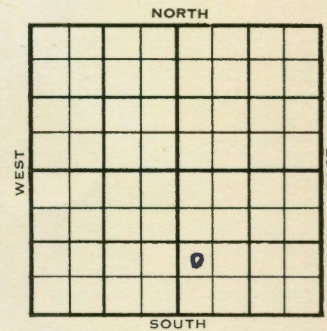

NW SW SE

	ELEVATION	REPORT
1954	2558'	
12/29	MIR	
1955		
2/2	Spud 12-29-54 Oil Well TD 3580' 10" @ 687' Howard. 3225' Top 3287' DST 3378'-94' opn 1 hr, rec 60' ocm, 980# Heeb 3418' Tor 3446' Lans 3460' TD 3580' 7" @ 3580' CO to 3578' 40/ 3565-75 32/ 3540-48 2500 A S/ 38½ bo 3½ baw. 8 hr. S/ 3 boph P/ 32 bopd. Comp 32 bopd. 3½ bw.	

COMPLETED

County	Decatur		State	Kansas	
Sec.	25	(Blk.) Twp.	4	(Sur.) Rge.	27W Map No.
Operator	Texas Company				
Well No.	2	Farm	Keenan		
Elev.	Location		NW SW SE		

FIRST REPORT

990	Ft. From	S	Line	SE
330	Ft. From	W	Line	Quarter
1st. Report DEC 29 1954				
Completion				
Remarks				
Powell - Contr.				
Spudding Date				

Drlg. Data Jennings Pool

M I R

FABEN GILSTRAP

County	Decatur			State	Kansas
Sec.	25	(Blk. Twp.)	4	(Sur. Rge.)	27W Map No.
Operator	Texas Company				
Well No.	2	Farm	Keenan		
Elev.	2558	Location	NW SW SE		

COMPLETE

990 Ft. From	S Line	SE ^c
330 Ft. From	W Line	Quarter
1st. Report		
Completion	FEB 2 1955	
Remarks	Jennings Pool	
Powell - Contr.		
Spudding Date	12-29-54	

Drig. Data	Oil well	TD 3580
10" @ 687	Howard 3225	Top. 3287
DST 3378-94	open 1 hr.	Rec. 60' ocm
980#	Heeb. 3418	Tor. 3446 Lens. 3460
TD 3580	7" @ 3580	CO to 3578
40/ 3565-75	32/ 3540-48	2500 A
S/ 38 $\frac{1}{2}$ bo	3 $\frac{1}{2}$ baw 8 hr.	S/ 3 boph
P/ 32 bopd	Comp. 32 bopd	3 $\frac{1}{2}$ bw

FABEN GILSTRAP