


Section 25 Township 4 Range 27 W

Well No. # 1 Keenan-Noone Unit

Company Texas Company

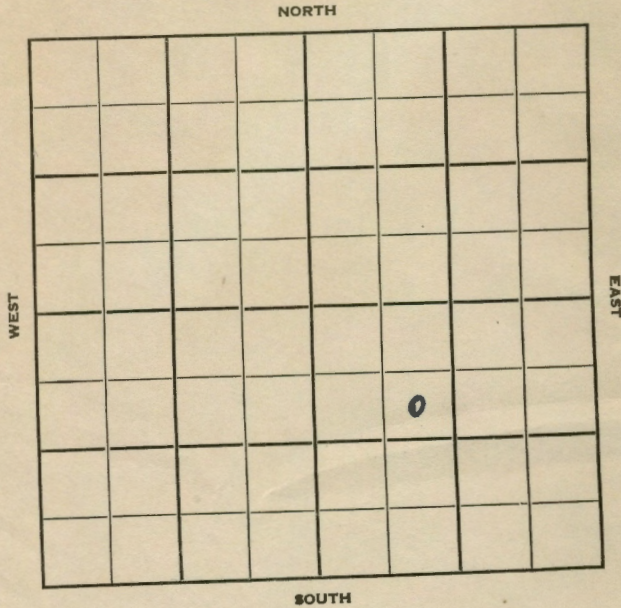

10

Sec. 25 Twp. 4 R. 27W

Well No. #1 Keenan-Noone Unit Farm _____

Texas Co. _____ Company _____

Contractor _____


990 Ft. from N. Line

_____ Ft. from S. Line

_____ Ft. from E. Line

990 Ft. from W. Line

SE NW SE

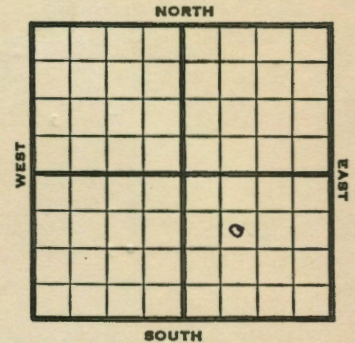

1952 **Elev. 2491'** REPORT

- 11/18 Spud 11-14-52
10" @ 275'
Drlg. 2350'
- 11/27 **Howard 3164?**
DST 3107-20, 1 hr., 20' M
DST 3125-46, 1 hr., 9' M, 820#
Topeka 3229, Heeb 3358, Lans 3400'
DST 3430-55, 1 hr., 32' M
DST 3478-85, 1 hr., 395'? SW
Drlg.
- 12/4 TD 3488' 7" @ 3488
- 12/11 CO 3464 31/3438-48 500A S/15 BW
PB 3422 19/3408 14 4 galwph 500A
- 12/17 Spud 11-14-52
Oil Well
TD 3488
10" @ 275'
Howard 3164
DST 3107-20, opn 1 hr., rec. 20'
mud, 100#
DST 3125-46, opn 1 hr., rec. 9'
mud, 820#

OVER

#1 Keenan-Noone Unit
(Information Brought Forward)

1952
12/17

Top 3229, Heeb 3358, Lans 3400
DST 3430-55, opn $1\frac{1}{2}$ hrs., rec.
32' mud, 530#
DST 3478-85, opn 1 hr., rec.
595' sw 730#
TD 3488
7" @ 3488
CO to 3464 31/3438-48, 500A
S/15 bw 24 hrs., PB 3422
19/3408-14, 4 gwph 500A
14 bwph PB 3395 19/3167-73
dry
19/3167-73 500A S/23 bo 5 bw
12 hrs., 1500A
S/ $3\frac{1}{2}$ bo $1\frac{1}{2}$ bwph
P/33 bo 10 bw
Comp. 98 bopd 30 bw

COMPLETED

