


Section 25 Township 4 Range 27W

Well No. #1 Munson

Company Texas

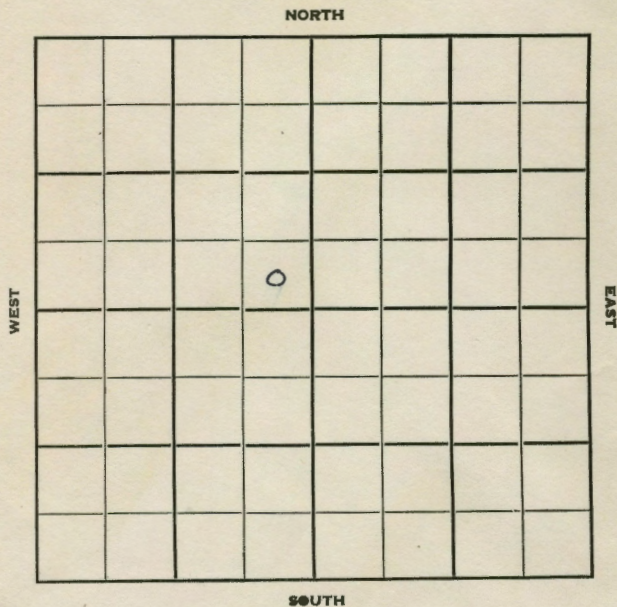

6

Sec. 25 Twp. 4 R. 27 W

Well No. #1 Munson Farm

Texas Company

Anschultz Jennings Contractor


Ft. from N. Line

330 Ft. from S. Line

330 Ft. from E. Line

Ft. from W. Line

SE SE NW

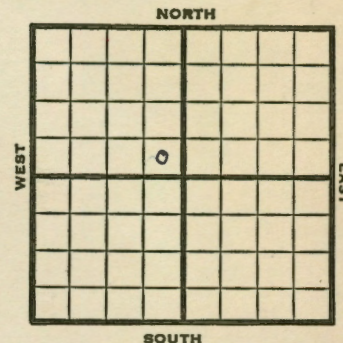

1951 Elev. 2489' REPORT

10/10 Spud 10-9-51
 1952 8" @ 350' WOC
 1/2 Spud 10-9-51
 Oil Well Td 3586
 8" @ 350
Howard 3155 Top. 3222
 DST 3221-31 open 1 hr. Rec. 90 SW
Heeb. 3351 Lans. 3392
 TD 3585 5" @ 3585 DD 3586
 S/ 4 BWP & SSO SP 3580
 15/ 3559-64 500 A 19/ 3536-42
 500 A SP 3525 19/ 3500-06
 500 A S/ 1/2 BWP SP 3492
 19/ 3472-78 S/ 24 BWP PB 3450
 13/ 3446-51 1000 A 15/ 3435-40
 500 A S/ 1 BW & SSO PH PB 3430
 16/ 3420-24 500 A S/ 12 BW 1 hr
 CO to 3453 S/ 10 BW 18/ 3404-08
 13/ 3402-06 CO to 3482 10/ 3469-72
 / 6 GWP 500 A S/ 28 BW 8 hr.
 SP 3415 24/ 3394-3400 PB 3415
 500 A S/ 1 1/2 BWP CO to 3466
 12/ 3461-64 500 A S/ 30 BWP
 SP 3442 18/ 3430-34 500 A S/ 4 1/2
 BWP 16/ 3392-99 SP 3388
 18/ 3380-84 500 A S/ 4 1/2 BWP
 19/ 3314-22 500 A 8/ 3315-17
 18/

OVER

1952

Information continued

1/2

18/ 3288-99 1000 A S/ 8 BW
SSO PH SP 3175 24/ 3156-62 S/ 16
GO 4 GWPH 500 A S/ 72 BO 10 BW
12 hr. S/ 4 BO
Comp. 157 BOPD 5% wtr.

COMPLETED

Drig. Data

12/ 3461-64 500 A S/ 30 bwph SP 3442
18/ 3430-34 500 A S/ 4 1/2 bwph
16/ 3392-99 SP 3388 18/ 3380-84 500 A
S/ 4 1/2 bwph 19/ 3314-22 500 A 8/ 3315-
17 18/ 3288-99 1000 A S/ 8 bw SSO ph
SP 3175 24/ 3156-62 S/ 16 go 4 gwph
500 A S/ 72 bo 10 bw 12 hr. S/ 4 bo
Comp. 157 bopd 5% water

JAN 9 1952

.....	Coat Cards
.....	Land Small Map
.....	Land Wall Map
.....	Tracings
.....	France Map
.....	Pierce Map
.....	Misc.