


Decatur

Section 25 Township 4 Range 27W

Well No. 1 Munson Townsite Unit

Company Texas Company

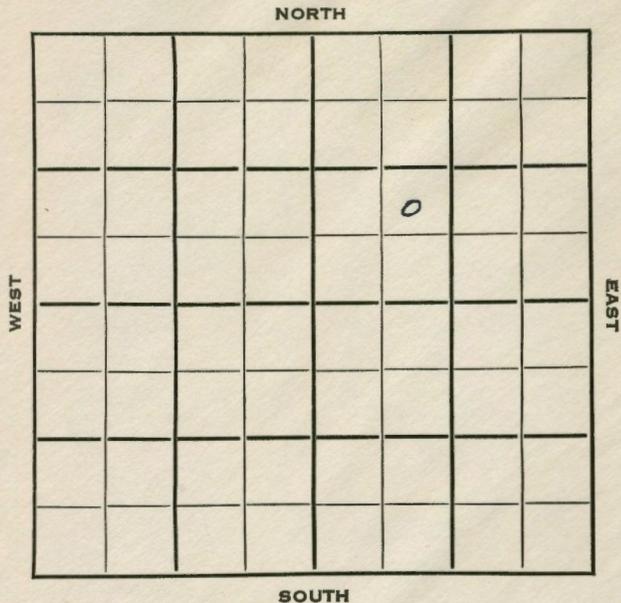

Decatur

Sec. 25 Twp. 4 R. 27W

Well No. #1 Munson Townsite Unit Farm

Texas Company Company


Contractor

\_\_\_\_\_ Ft. from N. Line

990 Ft. from S. Line

\_\_\_\_\_ Ft. from E. Line

990 Ft. from W. Line

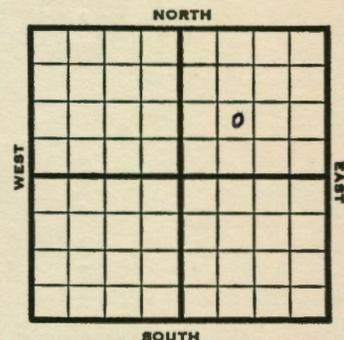

NE SW NE

1953 Elev. 2496' REPORT

1/14 Spud 1-8-53  
10" @ 678  
Drlg. 2625'

1/22 Howard 3185'  
DST 3180-3200 1 hr, 50' HOCM 600#  
Top 3252' Heeb 3379' Tor. 3408'  
Lans. 3422'  
DST 3513-40 1½ hrs, 50' M 100#  
DST 3578-3608, 1½ hrs, 12' M 35#  
DST 3606-16, 1½ hrs, 705' SW 1045#  
TD 3616' 7" @ 3611

1/29 CO, PB 3285  
19/3189-95, 500A  
S/8 BO + 8 BW 16 hrs.

2/3 Sq 3189-95 CO 3205 19/3189-95  
Dry 500 A S/6 BO plus 1¼ BWPH  
dec. to 3 GO plus 30 GWPH after 17 hrs  
Hyd. S/6½ BO plus 9 BW 6 hrs.

2/11 Spud 1-8-53  
Oil Well  
TD 3616  
10" @ 678  
Howard 3185  
DST 3180-3200, opn 1 hr., rec.  
50' hocm, 600#  
Top 3252, Heeb 3379, Tor 3408,  
Lans 3422

OVER

#1 Munson Townsite Unit  
(Information Brought Forward)

1953  
2/11

DST 3513-40, opn  $1\frac{1}{2}$  hrs., rec.  
50' mud, 100#  
DST 3578-3608, opn  $1\frac{1}{2}$  hrs., rec  
12' mud, 35#  
DST 3606-16, opn  $1\frac{1}{2}$  hrs., rec.  
705' sw, 1045#  
TD 3616  
7" @ 3611  
PB 3285  
19/3189-95, 500A  
S/8 bo 8 bw 16 hrs., sq.  
3189-95,  
CO to 3205  
19/3189-95 dry, 500A  
S/6 bo  $1\frac{1}{4}$  bwph, dec. to 3 go  
30 gwph after 17 hrs., Hydro  
S/6 $\frac{1}{2}$  bo 9 bw 6 hrs.  
Comp. 24 bopd 13 bw

**COMPLETED**

