


Section 25 Township 4 Range 27W

Well No. #4 M.T. Munson

Company Texas Company

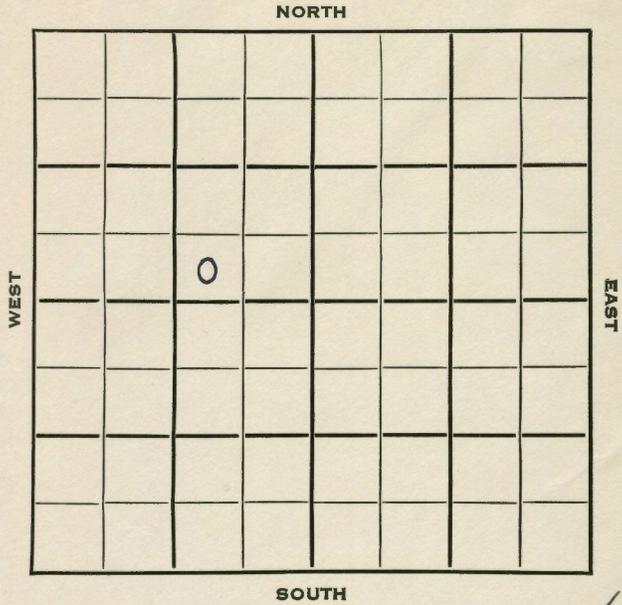

6

SEC.	TWP.	R.
25	4	27 W

WELL NO. #4 M. T. Munson FARM

COMPANY Texas Company

CONTRACTOR Hannum

Jennings Pool

_____ Ft. from N. Line

330 _____ Ft. from S. Line

990 _____ Ft. from E. Line

_____ Ft. from W. Line

SW SE NW

	ELEVATION	REPORT
1954	2481'	
1/6	Spud 1-3-54 MIR	
1/13	10" @ 648 Top 3218'	Howard 3150' Severy 3203'
1/20	TD 3499' Schl Tops: Lans 3387' 7" @ 3496'	Heeb 3345', Tor 3374',
1/27	NR	
3/3	Spud 1-3-54 Oil Well TD 3499' 10" @ 648' Howard 3150', Severy 3203', Top 3218' TD 3499' Heeb 3345', Tor 3374', Lans 3387' 7" @ 3496' CO to 3409' 19/3154-60, 2 1/2 go 3 gwph, 2000A S/3 bo 1/2 bwph P/49 bo 15 bw Comp. 25 bopd 25 bw	

COMPLETED

