

SEC. 36 TWP. 4 R. 27 W

WELL NO. # 2 Skubal FARM

COMPANY- Texas Company

CONTRACTOR Hannum Drlg. Jennings Pool


990 Ft. from N. Line

Ft. from S. Line

330 Ft. from E. Line

Ft. from W. Line

SE NE NW

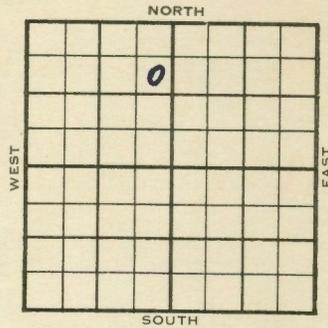

| | ELEVATION | REPORT |
|------|-----------|--------|
| 1953 | 2584' | |


12/2 Location
 12/9 10" @ 700
 Drlg. 1521'
 Drlg. 2700'
 12/16
 1954
 3/3 Spud 12-5-53
 Oil Well
 TD 3603'
 10" @ 700'
 Howard 3257', Top 3322', Heeb 3454',
 Lams 3495'
 TD 3603'
 7" @ 3601'
 CO to 3603', 16/3259-64, 1 goph 4 hrs.
 2000A
 S/1 bo 1 bw 6 hrs., 2000A
 1/2 bo 3 bwph 7 hrs.
 CO to 3519'
 16/3259-64, 1000A
 S/1 bo 1 bwph 17 hrs.
 Comp. 56 bopd 48 bw

COMPLETED

Section 36 Township 4 Range 27 W

Well No. # 2 Skubal

Company Texas Company

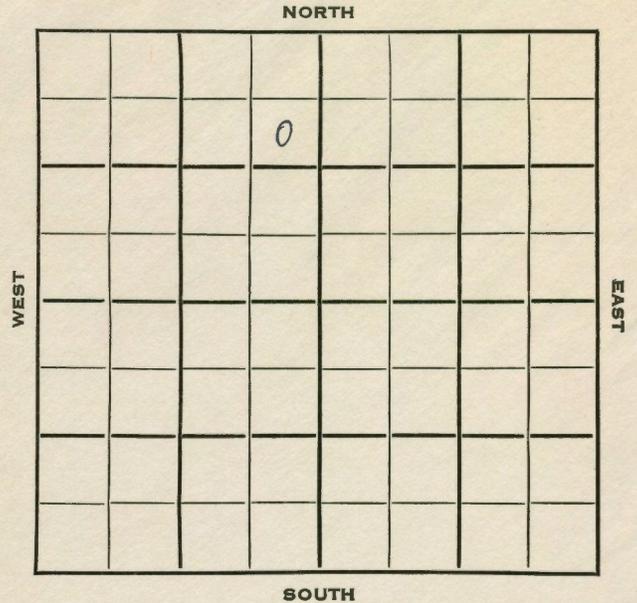

3

