


Section 36 Township 4 Range 27W

Well No. #1 T.A. Tacha

Company Texas Company

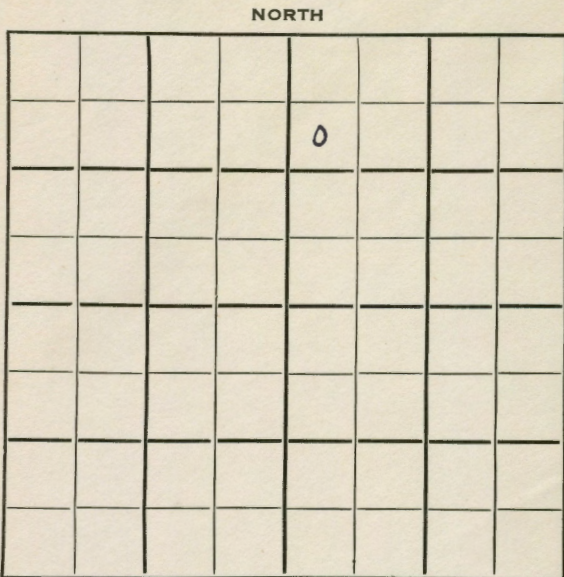

SOUTH

2

SEC. 36 TWP. 4 R. 27 W

WELL NO. #1 T. A. Tacha FARM

COMPANY Texas Company

CONTRACTOR Hannum Drlg.


Jannings Pool 990 Ft. from N. Line

Ft. from S. Line

Ft. from E. Line

330 Ft. from W. Line

SW NW NE

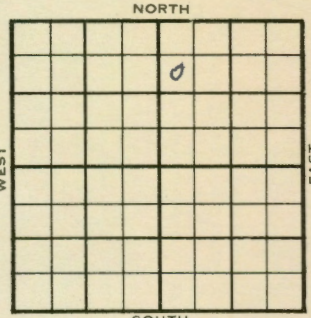

SOUTH

1954 ELEVATION 2563' REPORT

1/27 Spud 1-23-54
10" @ 700 Lost circ ?@1855'

2/10 Heeb 3432', Lans 3476'
TD 3580'
7" @ 3579'

2/17 CO 3518 16/3238-42 2000 A
S/1/2 BO + 2 1/2 BWP 13/3278-82
1000 A sq.

3/3 Spud 1-23-54
D&A
TD 3580'
10" @ 700'
Anhy 2061', Top 3302', Heeb 3432',
Lans 3476'
TD 3580'
7" @ 3579'
CO to 3518'
16/3238-43, 2000A, S/1/2 bo 2 1/2 bwph
13/3278-82, 1000A, CO to 3195, 10/
3186-90, 1 pt. oil 1 qt. wtr., 500A
S/1 3/4 bo 1 1/2 bw 3 hrs., 2000A
1 1/2 bo 1 bwph 4 hrs.
CO to 3249
16/3238-43, 1000A
S 3/4 bo 2 1/2 bwph 11 hrs.
S/1/2 bo 3/4 bwph 8 hrs.
D&A

DX-78

ABANDONED

