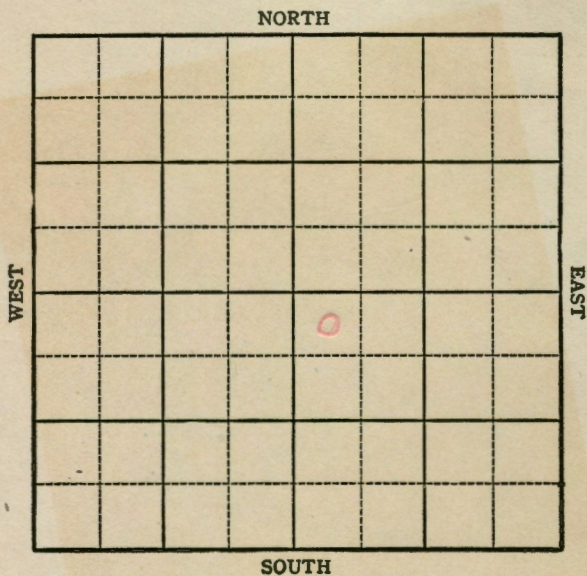


KANSAS

Decatur

Section 28 Township 4 Range 28WWell No. #1 Fred BremerCompany Sinclair-Prairie

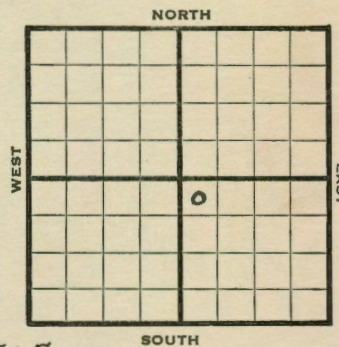
10

KANSAS

Decatur County

Sec. 28 Twp. 4 R. 28WWell No. #1 Fred Bremer FarmSinclair-Prairie Company

Wildcat

330 Ft. from N. Line Ft. from S. Line Ft. from E. Line330 Ft. from W. LineNW SE Elev 2707

1944

REPORT

8/9	Loc.
8/16	"
8/23	"
8/30	"
9/8	Rotary
9/13	13" @ 340' Drlg. 2690'
9/21	Tight hole
9/28	Drlg. 4437
10/4	Cong. 4114
	Arb. 4422
	TD 4656

ABANDONED

Pool Name WildcatMap No. MM Sec. 28 Twp. 4 R. 28WWell No. 1 Fred BremerSinclair-Prairie CompanyABANDONED Contractor

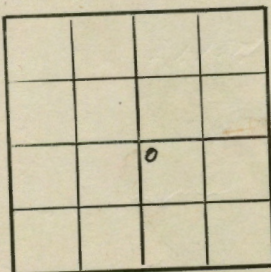
NW SE

SECTION PLAT

330 Ft. from N. Line

Ft. from S. Line

Ft. from E. Line

330 Ft. from W. Line

Decatur County

Location

Rig up

Drilling and Remarks:

Comp 4114
4422

RECORD

Cased in. ft.

Sand

Gas

Oil

Total Depth 4436

PRODUCTION

1st 24 hrs. Nat.

1st 24 hrs. after shot

Gas Cu. Ft.

Dry Hole

Abandoned

Date

OCT 4 1944 19

S. J. LEWIS Scout

Pool Name WildcatMap No. MM Sec. 28 Twp. 4 R. 28WWell No. 1 Fred BremerSinclair-Prairie CompanyFIRST REPORT Contractor

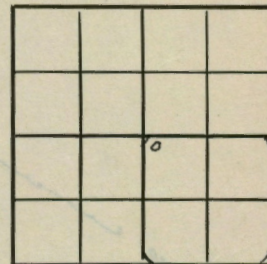
NW SE

SECTION PLAT

330 Ft. from N. Line

Ft. from S. Line

Ft. from E. Line

330 Ft. from W. Line

Decatur County

Location X

Rig up

Drilling and Remarks:

RECORD

Cased in. ft.

Sand

Gas

Oil

Total Depth

PRODUCTION

1st 24 hrs. Nat.

1st 24 hrs. after shot

Gas Cu. Ft.

Dry Hole

Abandoned

Date

AUG 9 1944 19

S. J. LEWIS Scout