


STATE OF KANSAS  
STATE CORPORATION COMMISSION

WELL PLUGGING RECORD

Give All Information Completely  
Make Required Affidavit  
Mail or Deliver Report to  
Conservation Division  
State Corporation Comm.  
245 North Water  
Wichita, KS 67202

Decatur County, Sec. 33 Twp. 4S Rge. 29W ~~E~~W  
Location as "NE/CNW $\frac{1}{2}$ SW $\frac{1}{2}$ " or footage from lines  
W/2 W/2 SW

Lease Owner F & M OIL CO., INC.  
Lease Name Anderson "E" Well No. 1  
Office Address 422 Union Center, Wichita, Kansas 67202  
Character of Well (Completed as Oil, Gas or Dry Hole) Dry

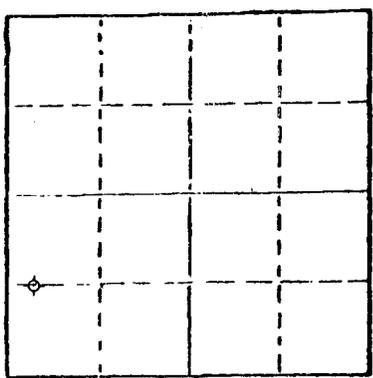

Locate well correctly on above Section Plat

Date Well completed August 29, 1982  
Application for plugging filed August 29, 1982  
Application for plugging approved August 29, 1982  
Plugging commenced August 29, 1982  
Plugging completed August 29, 1982  
Reason for abandonment of well or producing formation Dry

If a producing well is abandoned, date of last production 19

Was permission obtained from the Conservation Division or its agents before plugging was commenced? Yes

Name of Conservation Agent who supervised plugging of this well Carl Goodrow  
Producing formation \_\_\_\_\_ Depth to top \_\_\_\_\_ Bottom \_\_\_\_\_ Total Depth of Well \_\_\_\_\_  
Show depth and thickness of all water, oil and gas formations.

OIL, GAS OR WATER RECORDS

CASING RECORD

FORMATION	CONTENT	FROM	TO	SIZE	PUT IN	PULLED OUT

Describe in detail the manner in which the well was plugged, indicating where the mud fluid was placed and the method or methods used in introducing it into the hold. If cement or other plugs were used, state the character of same and depth placed, from \_\_\_\_\_ feet to \_\_\_\_\_ feet for each plug set.

Set 1st plug @ 1860' w/100 sxs  
Set 2nd plug @ 270' w/ 40 sxs  
Set 3rd plug @ 40' w/ 10 sxs  
10 sxs in the rat hole  
plug down @ 8:30 pm 8-29-82

(If additional description is necessary, use BACK of this sheet)

Name of Plugging Contractor Union Drilling Co., Inc.

STATE OF Kansas COUNTY OF Sedgwick, ss.

R. D. Messinger (employee of owner) or (owner or operator)  
of the above-described well, being first duly sworn on oath, says: That I have knowledge of the facts, statements, and matters herein contained and the log of the above-described well is filed and that the same are true and correct. So help me God.

(Signature) *R. D. Messinger*



STATE OF KANSAS  
 STATE CORPORATION COMMISSION  
 CONSERVATION DIVISION  
 200 DERBY BLDG,  
 WICHITA, KANSAS 67202

Rev. 12-11-80  
 FORM CP-1

**33-4-296**

P/

WELL PLUGGING APPLICATION FORM  
 FILE ONE COPY

API NUMBER 15-039-20,659 (OF THIS WELL)  
 (THIS MUST BE LISTED, IF NO API# AVAILABLE PLEASE NOTE DRILLING COMPLETION DATE.)

LEASE OWNER F & M OIL CO., INC.

ADDRESS 422 Union Center, Wichita, Kansas 67202

LEASE (FARM NAME) Anderson "E" WELL NO. 1

WELL LOCATION W/2 W/2 SW SEC. 33 TWP. 4S RGE. 29W (~~EAST~~) (WEST)

COUNTY Decatur TOTAL DEPTH 4390' FIELD NAME \_\_\_\_\_

OIL WELL \_\_\_\_\_ GAS WELL \_\_\_\_\_ INPUT WELL \_\_\_\_\_ SWD WELL \_\_\_\_\_ D&A XX

WELL LOG ATTACHED WITH THIS APPLICATION AS REQUIRED? Yes  
 (IF NOT STATE REASON WHY)

DATE AND HOUR PLUGGING IS DESIRED TO BEGIN Carl Goodrow

PLUGGING OF THIS WELL WILL BE DONE IN ACCORDANCE WITH K.S.A. 55-128 OF THE RULES AND REGULATIONS OF THE STATE CORPORATION COMMISSION

NAME OF COMPANY REPRESENTATIVE AUTHORIZED TO BE IN CHARGE OF PLUGGING OPERATIONS:

Lyle Cason ADDRESS Rt. 2, Box 48, Abbyville, Ks. 67510

PLUGGING CONTRACTOR Union Drilling Co., Inc. LICENSE NO. \_\_\_\_\_

ADDRESS 422 Union Center, Wichita, Kansas 67202

INVOICE COVERING ASSESSMENT FOR PLUGGING THIS WELL SHOULD BE SENT TO:

NAME F & M OIL CO., INC.

ADDRESS 422 Union Center, Wichita, Kansas 67202

AND PAYMENT WILL BE GUARANTEED BY APPLICANT OF ACTING AGENT.

RECEIVED  
 STATE CORPORATION COMMISSION

SEP 15 1982

CONSERVATION DIVISION  
 Wichita, Kansas

SIGNED: [Signature]  
 APPLICANT OR ACTING AGENT

DATE: September 8, 1982