



Section 3 Township 4 Range 29W
 Well No. 1 Wymore
 Company Jones, Shelburne & Farmer

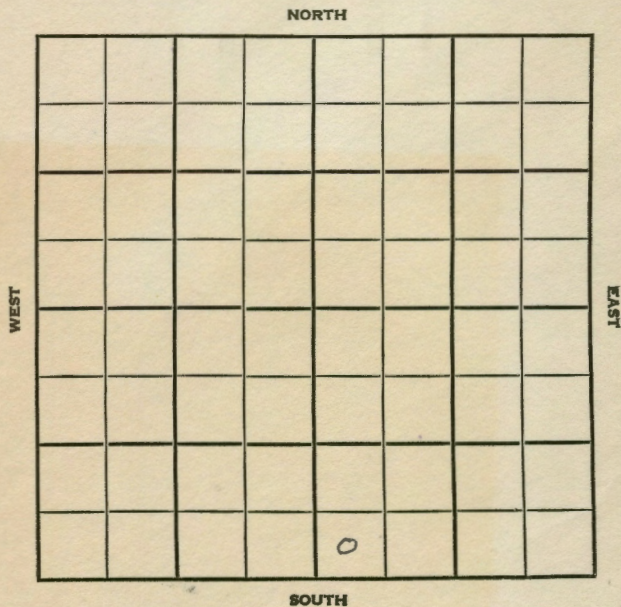

Decatur **KANSAS**
 SEC. 3 TWP. 4 R. 29 W
 WELL NO. # 1 Wymore FARM
 COMPANY Jones, Shelburne & Farmer
 CONTRACTOR Co. tools Wildcat

330 Ft. from N. Line
330 Ft. from S. Line
330 Ft. from E. Line
330 Ft. from W. Line

SW SW SE

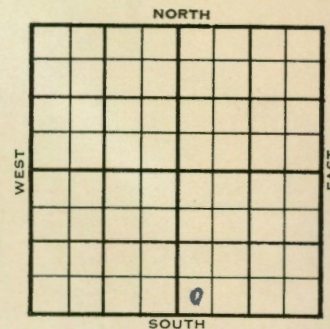

1955 ELEVATION **2799'** REPORT

3/30

4/20

Location

Spud 4-1-55

D & A

TD 4667'

8" @ 225'

Heeb. 3899', Tor. 3930' Lans. 3946'

DST 3959'-75' opn 1 hr, rec 31' Mud O#

DST 4090'-4125' opn 1 hr, rec 5' Mud O#

B KC 4143', Cong. 4363', Miss Chert.

4468' Viola 4535'

TD 4667'

Schlumberger Tops: **Heeb 3901', Tor 39**

32', KC 3948' Cong. 4368', Miss Lime.

4470', Viola 4539' Simp 4592', Arb.


4596'

TD 4667'

D & A

ABANDONED

County Decatur State Kansas
 Sec. 3 (Blk. 4 (Sur. 29W Map No.
 Operator Jones, Shelburne & Farmer
 Well No. 1 Farm Wymore
 Elev. 2799 Location SW SW SE

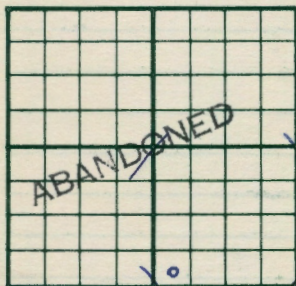

330 Ft. From S Line SE
330 Ft. From W Line Quarter

1st. Report

Completion APR 20 1955

Remarks Wildcat

Co. tools

Spudding Date 4-1-55

Drig. Data D & A TD 4667

8" @ 225 Heeb. 3899 Tor. 3930

Lens. 3946 DST 3959-75 open 1 hr.

Rec. 31' mud O# DST 4090-4125

open 1 hr. Rec. 5' mud O# B KC 4143

Cong. 4363 Miss. chert. 4468 Viola 4535

TD 4667 SCHLIMBERGER TOPS:

Heeb. 3901 Tor. 3932 KC 3948


Cong. 4368 Miss. lime 4470 Viola 4539

Simp. 4592 Arb. 4596 TD 4667

D & A

FABEN GILSTRAP

County Decatur State Kansas
 Sec. 3 (Blk. 4 (Sur. 29W Map No.
 Operator Jones, Shelburne & Farmer
 Well No. 1 Farm Wymore
 Elev. Location SW SW SE

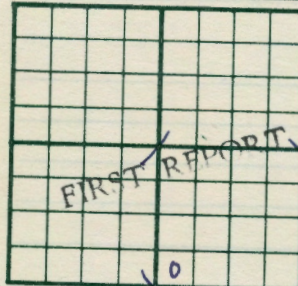

330 Ft. From S Line SE

330 Ft. From W Line Quarter

1st. Report MAR 30 1955

Completion

Remarks

Co. tools

Spudding Date

Drig. Data

Wildcat

Location

FABEN GILSTRAP