


KANSAS

FORM 31 5M PETROL

Rawlins

Section 14 Township 4 Range 35W
Well No. #1 E. Mullens
Company Stanolind

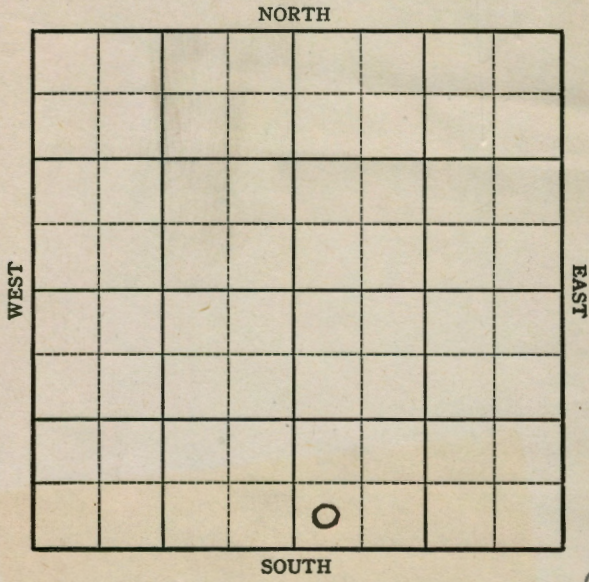

15


FORM 252A
5M 3-44 PETROL

Rawlins

Sec. 14 Twp. 4 R. 35W
Well No. #1 E. Mullens Farm
Stanolind Company

Wildcat

 Ft. from N. Line
330 Ft. from S. Line
 Ft. from E. Line
330 Ft. from W. Line

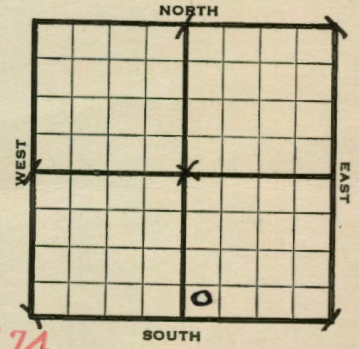

Elev. 3174


1944	REPORT
4/12	Rotary.
4/19	"
4/26	"
5/3	"
5/10	"
5/17	"
5/24	"
5/31	"
6/7	13" @ 283' Drlg. 2380'
6/15	Drlg. 3860
6/21	" "
6/28	No tops No TD

ABANDONED

Pool Name Wildcat
Map No. KANSAS Sec. 14 Twp. 4 R. 35W
Well No. 1 E. Mullens #11 Strat
Stanolind Company
ABANDONED Contractor

SW SE

SECTION PLAT

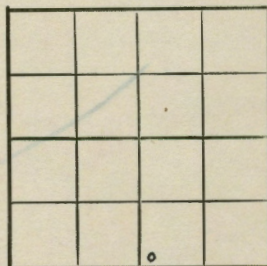

Ft. from N. Line
330 Ft. from S. Line
Ft. from E. Line
330 Ft. from W. Line

Rawlins County

Location

Rig up

Drilling and Remarks:

No Top
No T.D.

RECORD

Cased in., ft.
Sand
Gas
Oil
Total Depth

PRODUCTION

1st 24 hrs. Nat.
1st 24 hrs. after shot
Gas Cu. Ft.
Dry Hole
Abandoned

Date


JUN 28 1944 19

S. J. LEWIS Scout

Form 26 200 Bks 5-42 Petrol Rawlins
Map No. KANSAS Sec. 14 Twp. 4 R. 35W
Well No. 1 E. Mullens
Stanolind Company
FIRST REPORT Contractor

SW SE

SECTION PLAT

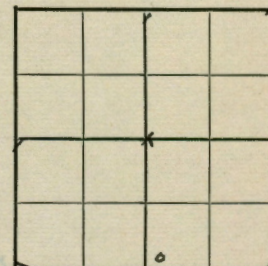

Ft. from N. Line
330 Ft. from S. Line
Ft. from E. Line
330 Ft. from W. Line

Wildcat

Location

Rig up

Drilling and Remarks:

Rotary

RECORD

Cased in., ft.
Sand
Gas
Oil
Total Depth

PRODUCTION

1st 24 hrs. Nat.
1st 24 hrs. after shot
Gas Cu. Ft.
Dry Hole
Abandoned

Date

APR 12 1944 19

S. J. LEWIS Scout