


Section 10 Township 5S Range 10W

Well No. #1 L. M. BEARD

Company HARRY MANN (BELOIT)

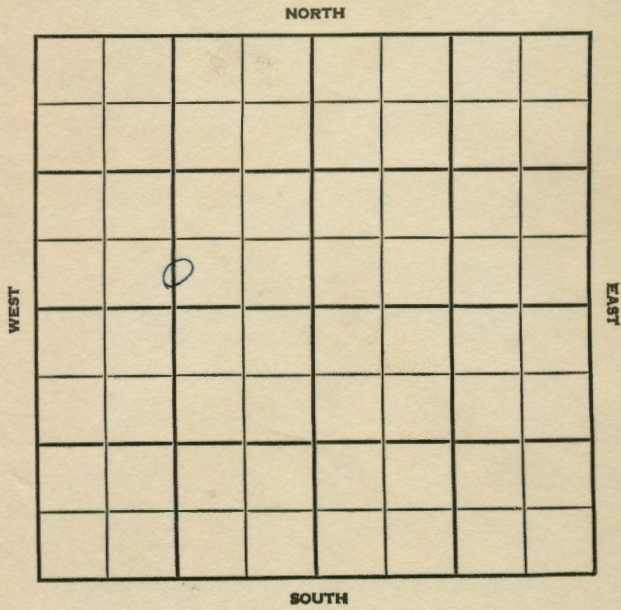

Jewell KANSAS

SEC. 10 TWP. 5S R. 10W

WELL NO. #1 L.M. Beard FAR

COMPANY Harry Mann (Beloit)

CONTRACTOR Mai Drlg.

WILDCAT

_____ FT. FROM N. LINE

_____ FT. FROM S. LINE

_____ FT. FROM E. LINE

_____ FT. FROM W. LINE

C S/2 S/2 NW

ELEVATION		REPORT
1956		
6-13	Loc.	3000' CT test

285422

FORM 513 SUNRAY

County Jewell Elev. _____
 Sec. 10 Twp. 5S Rgs. 10W
 Company Harry Mann (Beloit)
 FarmName L. M. Beard No. 1

TOPS	DEPTH	LOG	DATUM	Loc. in Sec.
Anh.				C S/2 S/2 NW
Tr.				
H.				
Tr.				
Dg.				
Bl.				
L.				
K.C.				
B.K.C.				
Geol.				
Geol.				
Cantr.				
Cantr.				
Mai Drlg.				
Pool				
Pool				
W. C.				
W. C.				
JUN 13 '56				
FIRST REPORT				

Date Comm. 3000' C.T. Test

JUN 1 2 1956

R.G.R

FORM 513 SUNRAY

County Jewell Elev. 1685 ft.
 Sec. 10 Twp. 5S Rgs. 10W 1649D7
 Company Harry Mann (Beloit)
 FarmName L. M. Beard No. 1

TOPS	DEPTH	LOG	DATUM	Loc. in Sec.
Anh.				C S/2 S/2 NW
Tr.				
H.				
Tr.				
Dg.				
Bl.				
L.				
K.C.				
B.K.C.				
Geol.				
Cantr.				
Cantr.				
Mai Drlg.				
Pool				
Pool				
W. C.				
W. C.				
JUN 13 '56				
FIRST REPORT				

ABANDONED

Date Comm. 3000' C.T. Test JUN 20 '56 6-16-56

10 500 JUN 27 '56 15" @ 375' 12"
@ 600 10 1700 JUL 3 '56 JUL 11 '56
8 78 175 2 10 1810 JUL 18 '56 10" @
8 21 JUL 25 '56 10 2100 AUG 1 '56 SW
@ 2150 AUG 8 '56 AUG 15 '56 8 58 236 0
10 2368 AUG 22 '56 10 2465 Hold Full
W.C. AUG 29 '56 8" @ 2475 10 2482
 SEP 5 '56 SEP 12 '56 S.D @ 2710 SEP 19 '56
 SEP 26 '56 OCT 10 '56 OCT 17 '56 OCT 24 '56
O.P.A. Hold