

Sec. 11 Twp. 5 R. 10W

Well No. #1 DeDay Bros. Farm

A. D. Allison et al Company

Wildcat

Contractor


Ft. from N. Line

330' Ft. from S. Line

330' Ft. from E. Line

Ft. from W. Line

SE SE SE

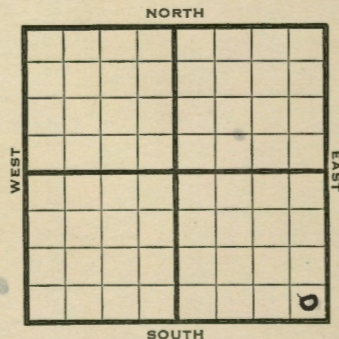

1950

REPORT

Elev 1761

8/23 Spud 8-18-50

Dakota 306'

Shut down @ 307

9/13 12" @ 80

Top 2510

Lans 2805

Kinderhook 3691

Simp 4097

Simp sh 4117

TD 4204

D&A

ABANDONED

Heeb 2745

Miss 3497

Hunton 3715

Viola 3831


Arb 4188

Section 11 Township 5 Range 10W

Well No. #1 DeDay Bros.

Company A. D. Allison et al


NORTH

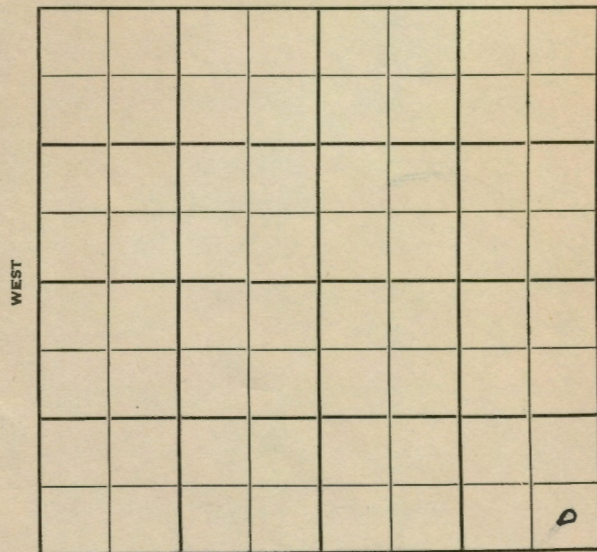

SOUTH

16

County Jewell State Kansas
 Sec. 11 (Blk. 5) (Sur. 10W) Map No.
 Operator A. D. Allison et al.
 Well No. 1 Farm DeDay Bros.
 Elev. 1761 Location SE SE SE

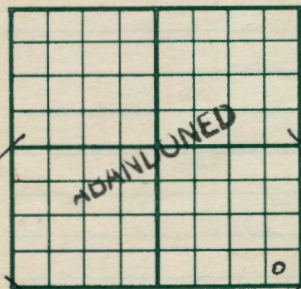

330 Ft. From S Line SE
 330 Ft. From E Line Quarter

1st. Report
 Completion SEP 13 1950

Remarks
Wildcat

Spudding Date 8-18-50

Drig. Data D & A TD 4204

12" @ 80 Top. 2510 Heeb. 2745 Lans. 2805


Miss. 3497 Kinderhook 3691 Hunton 3715

Simp. 4097 Viola 3831 Simp. sh. 4117

Arb. 4188 TD 4204 D & A

J. E. TYRA

County Jewell State Kansas
 Sec. 11 (Blk. 5) (Sur. 10W) Map No.
 Operator A. D. Allison et al.
 Well No. 1 Farm DeDay Bros.
 Elev. Location SE SE SE

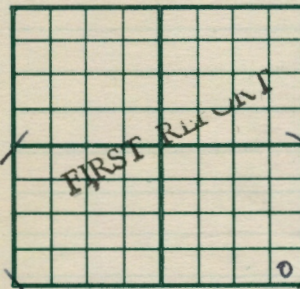

330 Ft. From S Line SE
 330 Ft. From E Line Quarter

1st. Report AUG 23 1950

Completion

Remarks

Spudding Date 8-18-50

Drig. Data

Wildcat

Dakota 306 shut down @ 307

J. E. TYRA