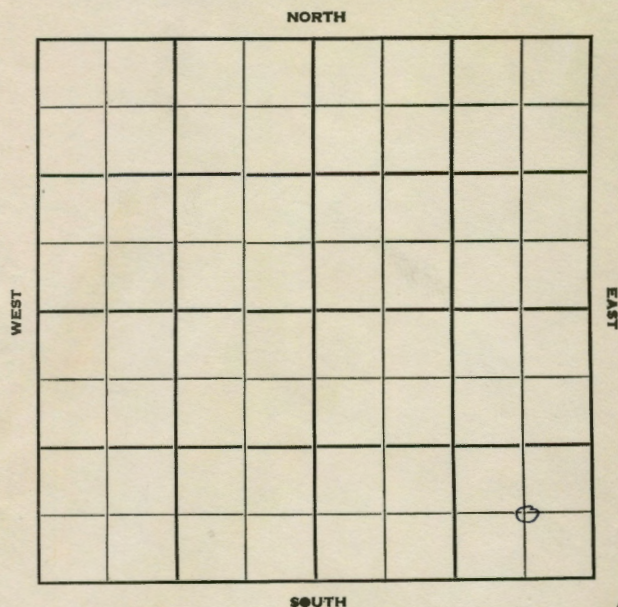


Section 30 Township 5 Range 10WWell No. #1 FreulichCompany Livermore

16

Jewell
Sec. 30 Twp. 5 R. 10WWell No. #1 Froelich FarmLivermore CompanySidey - Contr. Contractor
Wildcat

Ft. from N. Line

660'


Ft. from S. Line

660'

Ft. from E. Line

Ft. from W. Line

C SE SE

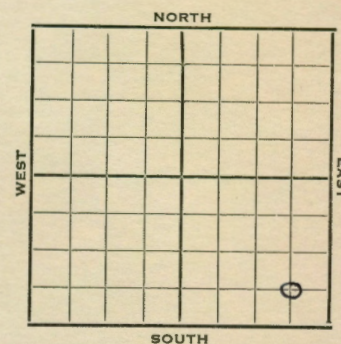

1951

Elev. 1570'

REPORT

12/12

Location

1952

1/2

Spud 12-11-51

D&A TD 3800

8" @ 220

Heeb 2540

Lans. 2619

Miss. 3247

Viola 3539

Simp sd 3746

TD 3800'

DST 3692-3708 open 1 hr. rec. 75' mud
D&A

Tor. 2564

KC 2720

Hunton 3443

Simp. dol. 3696

Arb. 3776

ABANDONED

County **Jewell** State **Kansas**

Sec. **30** (Blk. Twp.) **5** (Sur. Rge.) **10W** Map No.

Operator **Livermore**

Well No. **1** Farm **Freelich**

Elev. Location **C SE SE**

FIRST REPORT

660 Ft. From **S** Line **SE**

660 Ft. From **E** Line **Quarter**

1st. Report **DEC 1 2 1951**

Completion

Remarks **Sidey - Contr.**

Spudding Date

Drig. Data **Wildcat**

Drig. Data

Location

Kansas

State

County

Sec.

30

(Blk.)
(Twp.)

(Sik.
Twp.)

5

(Sur.
Rge.

(Sur.
Rge.

LOW

Map No.

Operator **Livermore**

Well No. **1** Farm **Freelich**

Elev.	Location	C	SE	SE
-------	----------	---	----	----

660 Ft. From S Line SE

660 Ft. From E Line Quarter

1st. Report DEC 1 2 1951

Completion


Remarks

Sidey - Contr.

Spudding Date

Wildcat

J. E. TYRA

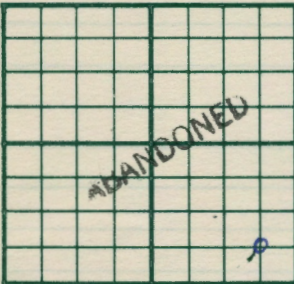County	Jewell			State	Kansas		
Sec.	30	(Blk. Twp.)	5	(Sur. Rge.)	10W	Map No.	
Operator	Livermore						
Well No.	1	Farm	Froelich				
Elev.	1570	Location	C SE SE				
				660	Ft. From	S Line	SE
				660	Ft. From	E Line	Quarter
				1st. Report			
				Completion JAN 2 1952			
Remarks				Wildcat			
				Sidney - Contr.			
Spudding Date				12-11-51			
Drig. Data	D & A			TD 3800			

Drig. Data

D & A

TD 3800

8" @ 220 Heeb. 2540 Tor. 2564

Lans. 2619 KC 2720 Miss. 3247

Hunton 3443 Viola 3539 Simp. dol. 3696

Simp. sd. 3746 Arb. 3776 TD 3800

DST 3692-3708 open 1 hr. Rec. 75' mud

D & A

J. E. TYRA