


Smith

Section 30 Township 5 Range 15W

Well No. #1 Anton Rehor

Company Stanolind

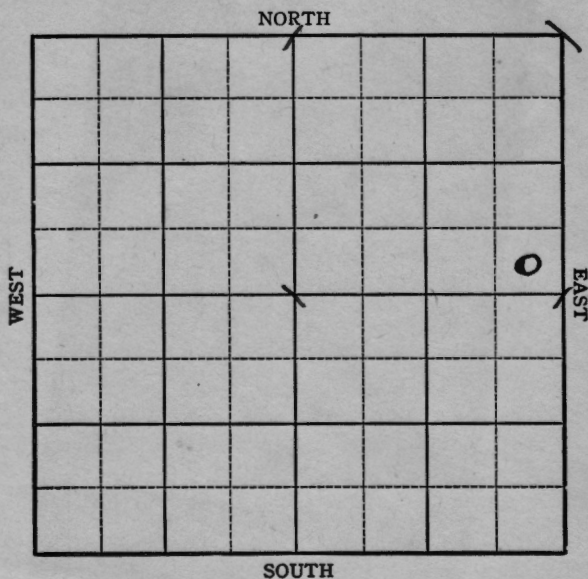

KANSAS

Smith

Sec. 30 Twp. 5 R. 15W

Well No. #1 Anton Rehor Farm


Stanolind Company

 Ft. from N. Line

330 Ft. from S. Line

330 Ft. from E. Line

 Ft. from W. Line

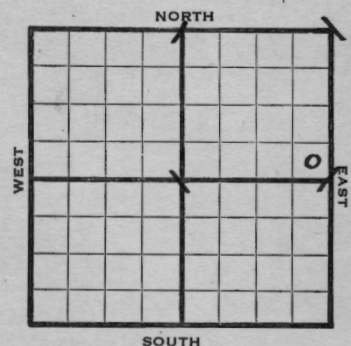

Wildcat

1944

REPORT

3/15 Location.
3/22 SH 120'
3/29 Drlg. 805'
4/5 8" @ 873'
drlg. 1965'
4/12 Topeka 2848
Lans 3108
SSO 3141-42
BKC 3385
Drlg. 3475
4/19 Miss 3663
Arb 3962
Simp 3924
Coring 3963
4/26 Miss 3663
Arb 3962
Viola 3870
Simp 3918
TD 4007
No shows.

ABANDONED

Pool Name WildcatMap No. 1316 Sec. 30 Twp. 5 R. 15WWell No. 1 Anton RehoreStanolind

Company

ABANDONED

Contractor

SE NE

SECTION PLAT

Ft. from N. Line

330

Ft. from S. Line

330

Ft. from E. Line

Ft. from W. Line

Smith County

Location

Rig up

Drilling and Remarks:

Misc 3643Ac 3942Vid 3870Sm 3918Nochore

RECORD

Cased in, ft.

Sand

Gas

Oil

Total Depth 4202

PRODUCTION

1st 24 hrs. Nat.

1st 24 hrs. after shot

Gas Cu. Ft.

Dry Hole

Abandoned

Date

APR 26 1944 19

S. J. LEWIS

Scout

Smith

KANSAS

Map No. 131 Sec. 30 Twp. 5 R. 15WWell No. 1 Anton RehoreStanolind

Company

FIRST REPORT

Contractor

SE NE

SECTION PLAT

Ft. from N. Line

330

Ft. from S. Line

330

Ft. from E. Line

Ft. from W. Line

Wildcat

Location X

Rig up

Drilling and Remarks:

RECORD

Cased in, ft.

Sand

Gas

Oil

Total Depth

PRODUCTION

1st 24 hrs. Nat.

1st 24 hrs. after shot

Gas Cu. Ft.

Dry Hole

Abandoned

Date

MAR 15 1944 19

S. J. LEWIS

Scout