
KANSAS
FORM 51 5M 1-42 PETROL

Phillips

Section 9 Township 5 Range 17-W

Well No. #1 Wheaton

Company Harbar Drilling & Jay

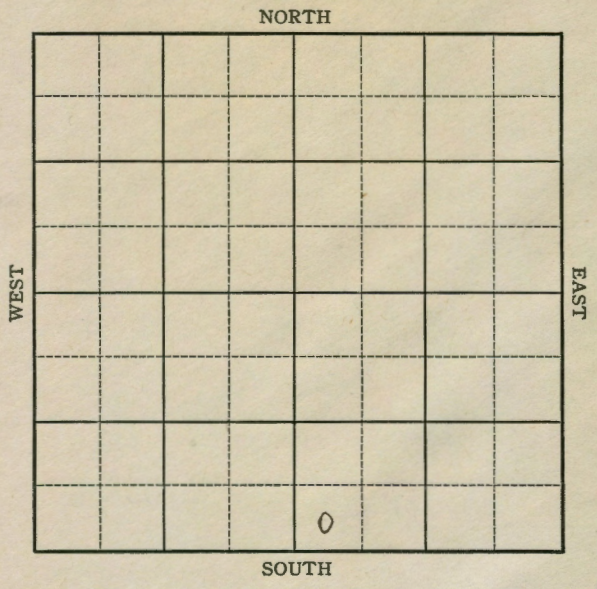

15

FORM 252-A
5M 9-42 GASS

KANSAS

Phillips

Sec. 9 Twp. 5 R. 17-W

Well No. #1 Wheaton Farm

Harbar Drilling & Jay Hawk Company

Wildcat


Ft. from N. Line

330 Ft. from S. Line

Ft. from E. Line

330 Ft. from W. Line

Elev. 1906

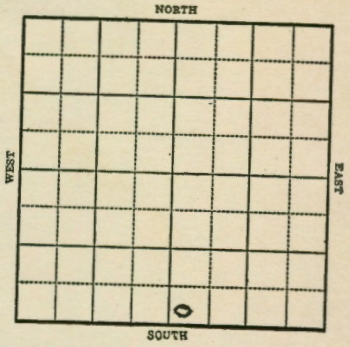

1943	REPORT
6/30	Location.
7/7	"
7/15	Rotary
7/21	10" L48' Anhy 1380 Ft. Riley 1960 Neva 2350 Topeka 2825 Dtlg. 2890'
7/28	Lans 3090 Sat. 3121-24 BKC 3362 Congl 3497 Sinp 3510 Arb 3560 T.D. 3610 No shows run csg to 3300'
8/4	5" @ 3325 24 shots 3219-27 SO 12 shots 3219-27
8/11	1000 acid SSO & W 36 shots 3219-27-3000 acid Testing.
8/18	"
8/25	"
9/1	"

OVER

1943
9/8

Arb 3560'
5" @ 3325'
T.D. 3610'

ABANDONED

Form 26 200 Bks 5-42 Petrol **Phillips**

KANSAS

Map No. 132 Sec. 9 Twp. 5 R. 17W

Well No. 1 Wheaton

Harbar Drilling & Jayhawk Company

ABANDONED Contractor

SW SE

Ft. from N. Line


330 Ft. from S. Line

Ft. from E. Line

330 Ft. from W. Line

WILDCAT

SECTION PLAT

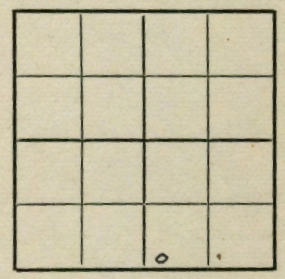

Location

Rig up

Drilling and Remarks:

Cir & 3560
5"@3325

RECORD

Cased in., ft.

Sand

Gas

Oil

Total Depth 3616

PRODUCTION

1st 24 hrs. Nat.

1st 24 hrs. after shot

Gas Cu. Ft.

Dry Hole

Abandoned

Date

SEP 8 1943 19 S. J. LEWIS Scout

Form 26 200 Bks 5-42 Petrol **Phillips**

KANSAS

Map No. 132 Sec. 9 Twp. 5 R. 17W

Well No. 1 Wheaton

Harbar Drilling & Jay Hawk Company

FIRST REPORT Contractor

SW SE

Ft. from N. Line


330 Ft. from S. Line

Ft. from E. Line

330 Ft. from W. Line

WILDCAT

SECTION PLAT

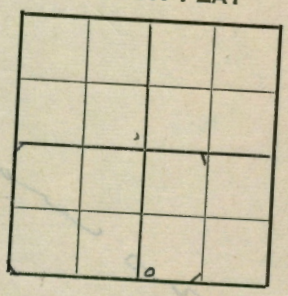

Location XXX

Rig up

Drilling and Remarks:

RECORD

Cased in., ft.

Sand

Gas

Oil

Total Depth

PRODUCTION

1st 24 hrs. Nat.

1st 24 hrs. after shot

Gas Cu. Ft.

Dry Hole

Abandoned

Date

JUN 30 1943 19 S. J. LEWIS Scout