


Map No. **KANSAS** Sec. 24 Twp. 5 R. 18W  
 Well No. 1 Donaldson Farm \_\_\_\_\_  
Ashby Company

*Phillips*

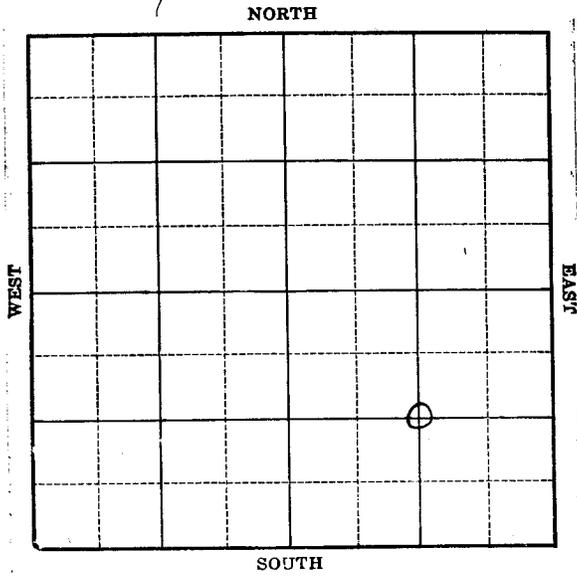

9

Location \_\_\_\_\_  
 Drilling Remarks \_\_\_\_\_

Rig Up \_\_\_\_\_  
 Drilling Remarks \_\_\_\_\_


**RECORD**  
 Cased \_\_\_\_\_ in. \_\_\_\_\_ ft.  
 Sand \_\_\_\_\_  
 Gas \_\_\_\_\_  
 Oil \_\_\_\_\_  
 Total Depth \_\_\_\_\_

**PRODUCTION**  
 1st 24 hrs. Nat. \_\_\_\_\_  
 1st 24 hrs. after shot \_\_\_\_\_  
 Gas \_\_\_\_\_ cu. ft.  
 Dry Hole \_\_\_\_\_  
 Abandoned \_\_\_\_\_

Map No. **KANSAS** Sec. 24 Twp. 5 R. 18W  
 Well No. 1 Donaldson Farm \_\_\_\_\_  
Ashby Company

*Phillips*

\_\_\_\_\_ Ft. from N. Line  
1320' Ft. from S. Line  
1320' Ft. from E. Line  
 \_\_\_\_\_ Ft. from W. Line

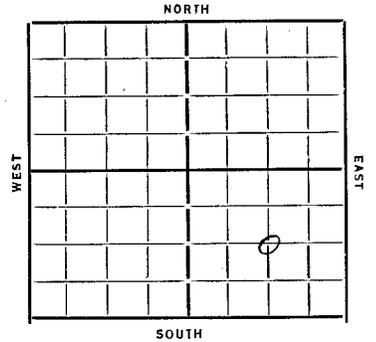

Date	REPORT
1/30	Rig
1/17	Spud
1/24	" + S.D
1/31	12" 1055 Run 10" 1350
2/7	—
2/14	Dily 1995
2/23	" 1950
2/1	NR 10" 1950
3/8	Dily 2200
3/15	Rhu 6" 2350
3/22	Dily 2673 6" at 2349
3/29	" 2715 6" at 2653
4/5	Log 2945
4/12	6" 2855 S.O. 3165-70
	S.O. 3186-92 TD
4/19	S.O. 3227-35 TD 3239 8 oil
	10 W. per day 1000 Gal acid
	No test Laking 3095
4/26	No results from acid 5" 3267
	dily 3285
5/3	Dily 3420
5/10	—

- OVER -

5/16 Lansing 3095 T D 3455  
D & A

**ABANDONED**

Form 26 - Phillips

Map No. 132 Sec. 24 Twp. 5 R. 18W

Well No. 1 - Woodardson

Asby Company Contractor

FIRST REPORTS

SECTION PLAT

1326 Ft. from N. Line
1326 Ft. from S. Line
1326 Ft. from E. Line
Ft. from W. Line

Section plat grid with a dot in the bottom right cell.

Location
Rig up
Drilling and Remarks:

rig

RECORD
Cased in, ft.
Sand
Gas
Oil
Total Depth

PRODUCTION
1st 24 hrs. Nat.
1st 24 hrs. after shot
Gas Cu. Ft.
Dry Hole
Abandoned

Date 1-10-34 192 Orval Mannschreck Scout

Form 26 - Phillips

Map No. 132 Sec. 24 Twp. 5 R. 18W KANSAS

Well No. 1 - Woodardson

Asby Company Contractor

ABANDONED

SECTION PLAT

1320 Ft. from N. Line
1320 Ft. from S. Line
1320 Ft. from E. Line
Ft. from W. Line

Section plat grid with a dot in the bottom right cell.

Location
Rig up
Drilling and Remarks:

Lansing 3095

10 + FT

RECORD
Cased in, ft.
Sand
Gas
Oil
Total Depth 3455

PRODUCTION
1st 24 hrs. Nat.
1st 24 hrs. after shot
Gas Cu. Ft.
Dry Hole
Abandoned

Date 5-16-34 19 Orval Mannschreck Scout