


Section 24 Township 5 Range 18-W
 Well No. #1 Jones
 Company Laura Jane Oil

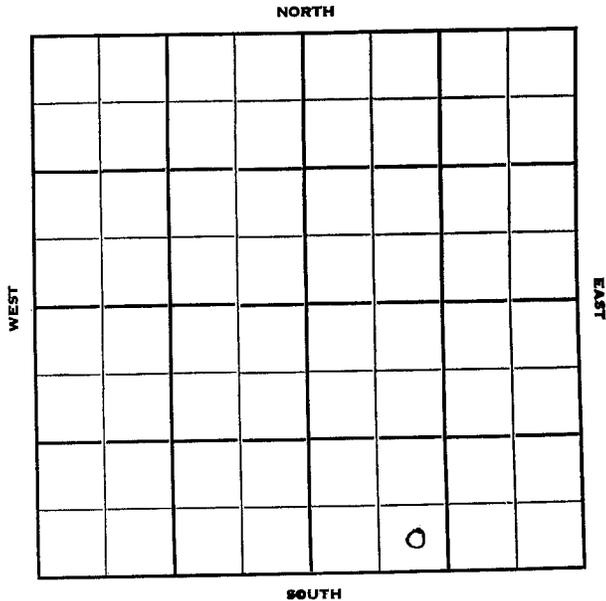

Sec. 24 Twp. 5 R. 18W ✓
 Well No. #1 Jones Farm
Laura Jane Oil Company

Contractor Wildcat


_____ Ft. from N. Line

330' Ft. from S. Line

_____ Ft. from E. Line


990' Ft. from W. Line

SE SW SE

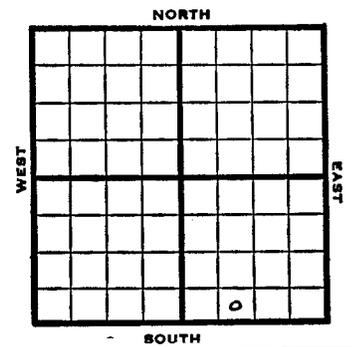

1950	Elev. 1962'	REPORT
11/1		Spud 10-25-50 8" @ 115' Anhy 1370' Drig. 2480'
12/27		Spud 10-25-50 Oil Well TD 3340 8" @ 115' Anhy 1370 Lans. 3115' DST 3135-65 opn 10 min Rec. 186' oil & mud SO 3202-08 TD 3340 5" @ 3340 Toronto 3098 Heeb. 3075 24/3204-10 24/3160-66 12/3162-64 FU 500' oil 45 min. 18/3160-66 FU 1200' oil 3 hr. S/8 BOPH 1000 A S/20 boph Comp. 50 bopd COMPLETED

County Phillips State Kansas
 Sec. 24 (Blk. 5 (Sur. 18W Map No.
 Operator Laura Jane Oil
 Well No. 1 Farm Jones
 Elev. 1962 Location SE SW SE

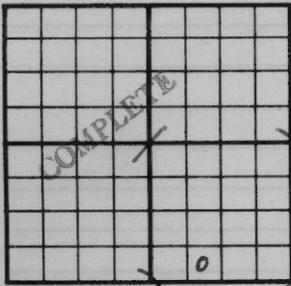

530 Ft. From S Line SE
990 Ft. From W Line Quarter
 1st. Report _____
 Completion DEC 27 1950
 Remarks Wildcat
 Spudding Date 10-25-50

Drig. Data Oil well TD 3340
8" @ 115 Anhy 1370 Lans. 3115
DST 3135-65 open 10 min. Rec. 136' oil
& mud SO 3202-08 TD 3340 5" @ 3340
Toronto 3098 Heeb. 3075 24/ 3204-10
24/ 3160-66 12/ 3162-64 FU 500' oil
45 min. 18/ 3160-66 FU 1200' oil 3 hr.
S/ 8 boph 1000 A S/ 20 boph
Comp. 50 bopd

J. E. TYRA