


Section 24 Township 5 Range 18 W

Well No. # 2 Jones

Company Laura Jane Oil

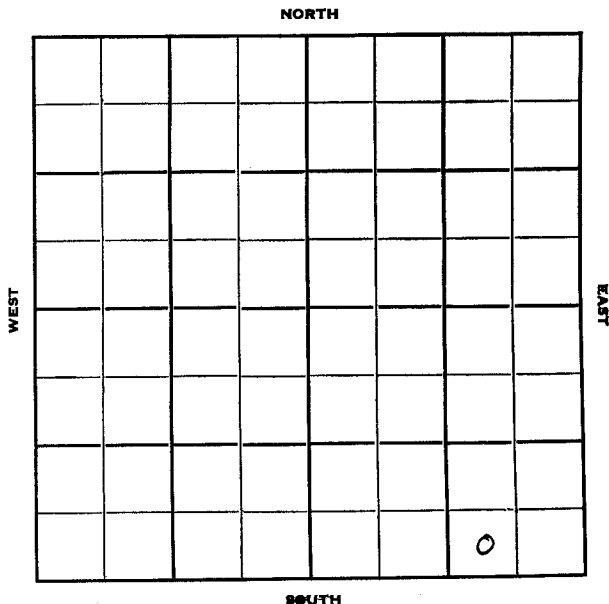

Sec. 24 Twp. 5 R. 18W

Well No. #2 Jones Farm

Laura Jane Oil Company

Contractor

Bow Creek Pool


Ft. from N. Line

330' Ft. from S. Line

990' Ft. from E. Line

Ft. from W. Line

SW SE SE

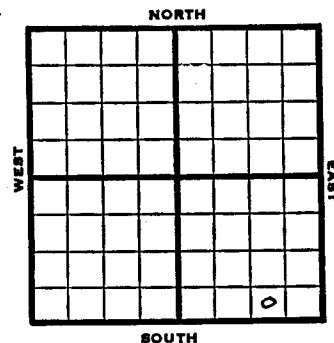

1951 Elev. 1927' REPORT

7/3 Spud 6-25-51
8" @ 136
Drlg. 3130'

8/29 Spud 6-25-51
Oil Well TD 3270
8" @ 136
Dakota sand 665-755 Anhy 1355-1445
Heeb. 3040 Lans. 3080
DST 3098-3140 opn 15 min. Rec. 80' mud
DST 3148-78 opn 41 min. Rec. 15' oil
25' ocm TD 3270 5" @ 3270
DD 3271 8/3262-66 10/3220-22
S/4 bwph PB 3210 10/3171-73
15/3171-77 B/3 bo 3 bw 1/2 hr
SP 3151 18/3128-34 2000 A
S/3 boph Comp bopd


COMPLETED

County Phillips State Kansas
 Sec. 24 (Blk.) 5 (Sur.) 18W Map No.

Operator Laura Jane Oil

Well No. 2 Farm Jones

Elev. _____ Location SW SE SE

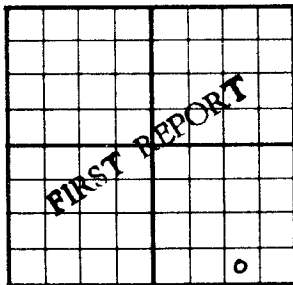

330 Ft. From S Line SE

990 Ft. From S Line Quarter

1st. Report JUL 3 1951

Completion _____

Remarks _____


Spudding Date 6-25-51

Drig. Data Bow Creek - pool

8" @ 136' Drgl. 3130

J. E. TYRA

County Phillips State Kansas
 Sec. 24 (Blk. 5) (Sur. 18W) Map No.
 Operator Laura Jane Oil
 Well No. 2 Farm Jones
 Elev. 1927 Location SW SE SE

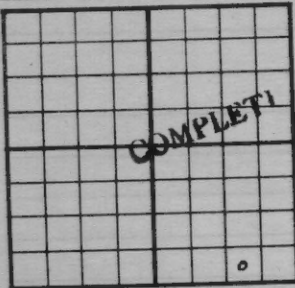

330 Ft. From S Line SE
 990 Ft. From E Line Quarter

1st. Report

Completion AUG 29 1951

Remarks Bow Creek Pool

Spudding Date 6-25-51

Drilg. Data Oil well TD 3270
8" @ 136 Dakota sand 665-755 Anhy 1355-
1445 Heeb. 3040 Lans. 3080 DST 3098-
3140 open 15 min. Rec. 80' mud
DST 3148-78 open 41 min. Rec. 15' oil
25' ocm TD 3270 5" @ 3270 DD 3271
8/ 3262-66 10/ 3220-22 S/ 4 bwph
PB 3210 10/ 3171-73 15/ 3171-77 B/ 3 bo
3 bw $\frac{1}{2}$ hr. SP 3151 18/ 3128-34 2000 A
S/ 3 boph Comp. 25 bopd

J. E. TYRA