


Section 25 Township 5 Range 18-W
Well No. 1 ~~Donaldson~~ Donaldson
Company Blue Stem Oil

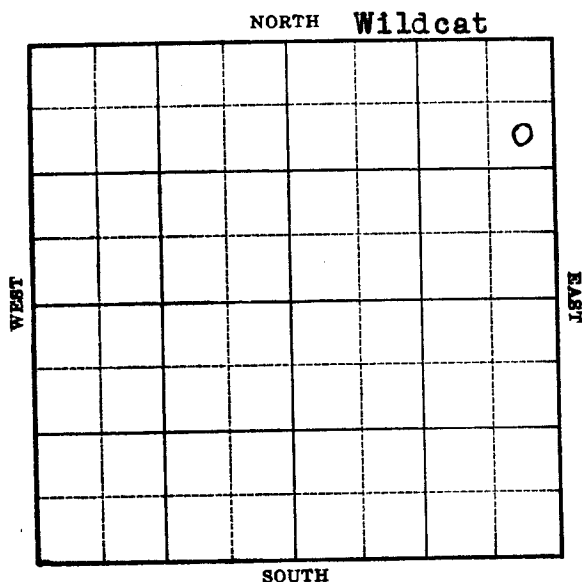

Sec. 25 Twp. 5 R. 18-W
Well No. #1 Donaldson Farm
Blue Stem Oil Company

(Wildcat)


990 Ft. from N. Line

_Ft. from S. Line

330 Ft. from E. Line

Ft. from W. Line

Elev. 1930

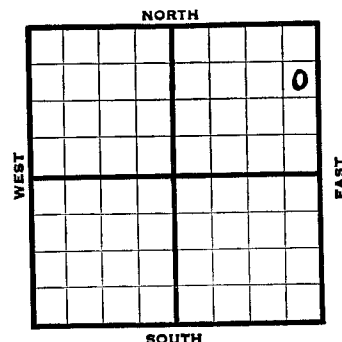

	REPORT
1939	
3/22	R.U.C.T.
3/31	Spud .
4/7	15" - 495' Drlg. 790'
4/14	13" - 807' Drlg. 1265'
4/21	Anh. 1330' 10" - 1340' Drlg. 2010'
4/28	8" - 2315' Drlg. 2535'
5/5	8" - 2571' Cement cave 2665'
5/12	7" - 2990' Drlg. 3010'
5/19	Lans. 3080' 7" - 3080' T.D. 3100' 700' oil. Rig burned.
5/26	Oil 40. Gravity. Waiting on rig.
6/1	" " "
6/8	Drilling 3115'
6/16	40' - 5" liner 3120' Pay 3100-13' T.D. 3164' 1500' oil, no time. Run tubing.
	OVER

1939
6/21

Lans. 3080'
7" - 3080'
40' of 5" liner.
T.D. 3164'
5000 acid.
Pump 827 bbls, potential.
40. Gravity.

COMPLETED

