FORM 51 25M 8-50 WESTERN

KANSAS

Phillips

Section 36 Township 5 Range 18W

Well No. #1 Muir

Company Honaker Drlg.

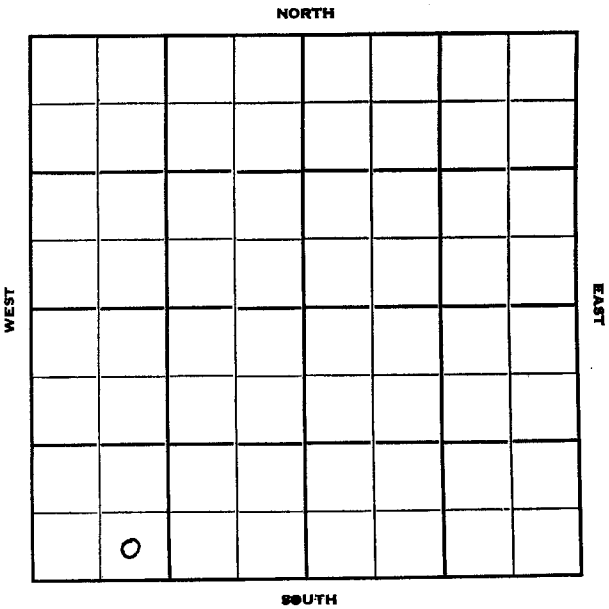

13

FORM 252-B
10M 11-50 PETROL

Phillips KANSAS

Sec. 36 Twp. 5 R. 18W

Well No. #1 Muir Farm

Honaker Drlg. Company

Contractor

Wildcat

Ft. from N. Line

330' Ft. from S. Line

Ft. from E. Line

990' Ft. from W. Line

SE SW SW

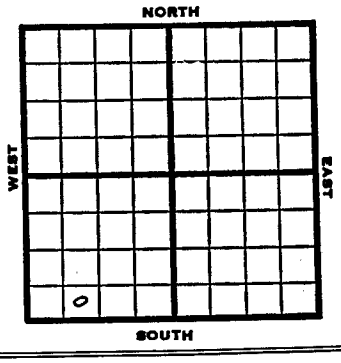

1951	Elev. 1886' REPORT
2/7	RUR
2/21	Spud 2-6-51 D & A TD 3503 8" @250 Anhy 1420 Heeb. 2994 Lans. 3037 DST 3229-52 open ½ hr. rec. 20' mud tr. of oil Cong. 3392 Ch. Cong 3479 TD 3503 D & A **ABANDONED**

FORM 275 FOR SALE BY KANSAS BLUE PRINT CO.

County Phillips State Kansas

Sec. 36 (Blk. Twp.) 5 (Sur. Rge.) 18W Map No.

Operator Honaker Drlg.

Well No. 1 Farm Muir

Elev. Location SE SW SW

FIRST REPORT

330 Ft. From S Line SW

990 Ft. From W Line Quarter

1st. Report FEB 7 1951

Completion

Remarks

Spudding Date

Drlg. Data Wildcat

R U R

J. E. TYRA

FORM 275 FOR SALE BY KANSAS BLUE PRINT CO.

County Phillips State Kansas

Sec. 36 (Blk. Twp.) 5 (Sur. Rge.) 18W Map No.

Operator Honaker Drlg.

Well No. 1 Farm Muir

Elev. 1886 Location SE SW SW

ABANDONED

330 Ft. From S Line SW

990 Ft. From W Line Quarter

1st. Report

Completion FEB 21 1951

Remarks Wildcat

Spudding Date 2-6-51

Drlg. Data D & A TD 3503

8" @ 250 Anhy 1420 Heeb. 2994

Lans. 3037 DST 3229-52 open ½ hr.

Rec. 20' mud tr. of oil Cong. 3392

Ch. Cong. 3479 TD 3503

D & A

J. E. TYRA