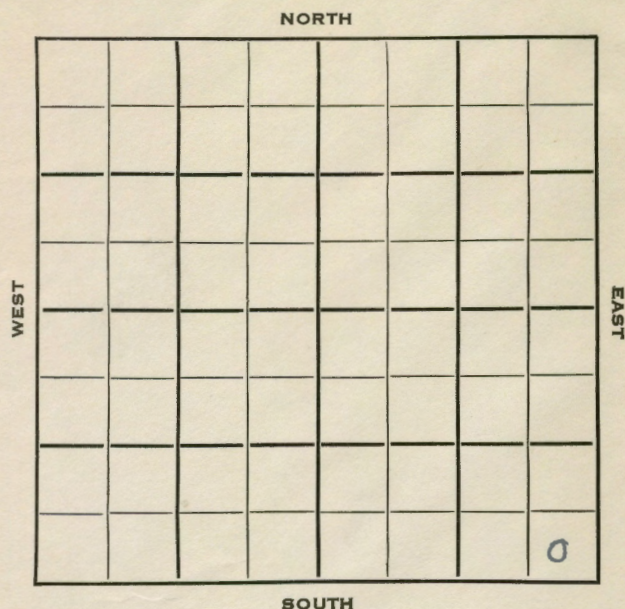


Section 31 Township 5 Range 19WWell No. #1 V. HillCompany Isern Drlg.

16

Sec. 31 Twp. 5 R. 19WWell No. #1 V. Hill Farm

Isern Drlg. Company

Isern Drlg. Contractor

Wildcat


Ft. from N. Line

330 Ft. from S. Line

330 Ft. from E. Line

Ft. from W. Line

SE SE SE

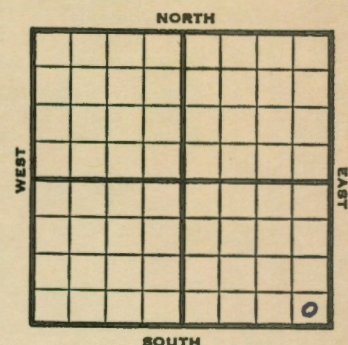

1953

Elev. 2043'

REPORT

4/22 Spud 4-19-53
8" @ 210, WOC4/29 Spud 4-19-53
D&A

TD 3560

8" @ 210

Anhy 1602, Heeb 3238, Lans 3276

DST 3325-55, opn $\frac{1}{2}$ hrs., rec. 15' mud
1140#

B KC 3488, Arb. 3531

TD 3560

D&A

ABANDONED

[illegible]

D & A

J G McGEHEE

County	Phillips	State	Kansas
Sec.	31	(Blk. Twp.)	5
		(Sur. Rge.)	19W
Operator	Isern Drlg.		
Well No.	1	Farm	V. Hill
Elev.		Location	SE SE SE

		330 Ft. From	S Line	SE
		330 Ft. From	E Line	Quarter
		lst. Report	APR 22 1953	
		Completion		
		Remarks	Isern Drlg. - Contr.	
		Spudding Date	4-19-53	
			Wildcat	

8⁰⁰ @ 210 WOC

Wildcat

8 @ 210 WOC

J. G. McGEHEE