


KANSAS

Phillips County

Section 34 Township 5 Range 19W

Well No. #1 Thayer

Company Skelly

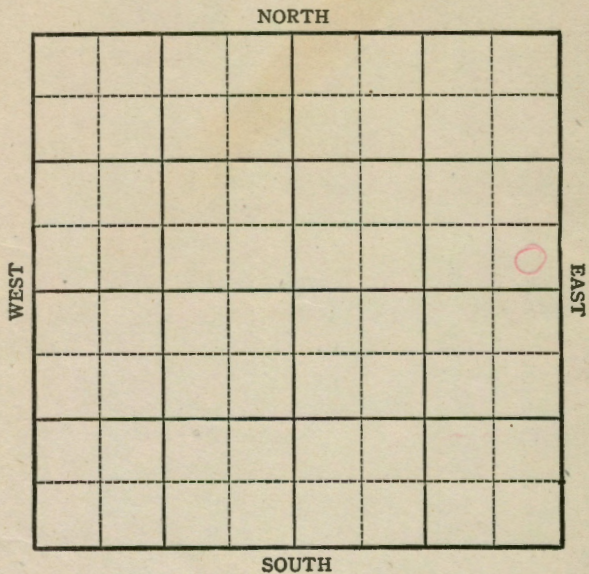

8

KANSAS

Phillips County

Sec. 34 Twp. 5 R. 19W

Well No. #1 Thayer Farm _____

Skelly Company _____


Wildcat
_____ Ft. from N. Line

330 Ft. from S. Line

330 Ft. from E. Line

_____ Ft. from W. Line

SE NE 1982

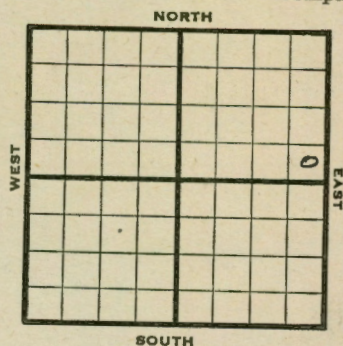

1944

REPORT

11/8 Location
11/16 8" @ 235' WOC
11/24 Drlg. 2550
11/29 Lans 3204 SC 3265-3280 BKC 3427
Arb. 3495-3490 TD SSO 5" @3486
RUST
12/6 " " " " " " " "
12/14 " " " " " " " "
12/21 " " " " " " " "
12/29 " " " " " " " "
1945
1/3 TD 3498 - 2000 ' water per da.
1/10 Arb 3480 corrected
5" @ 3481 TD 3485 PB 3398
47 shots 3374-84 ; 48 shots 3320-26
24 shots 3375-83
2000 acid
1/17 3000 acid pump 5 oil & 7 wtr in 7 hrs
1/26 1000 acid.
Pump 4 oil plus 36 Water in 12 hrs.
1/31 Arb. 3480
5" @ 3481
TD 3503 water

ABANDONED

Pool Name Wildcat

Map No. K-133 Sec. 34 Twp. 5 R. 19W

Well No. 1 Thayer

Skelly Company

ABANDONED Contractor

SE NE

SECTION PLAT

 Ft. from N. Line

330 Ft. from S. Line

330 Ft. from E. Line

 Ft. from W. Line

Phillips County

Location

Rig up

Drilling and Remarks:

*Cor 3480
5' 103491
Na 768*

RECORD

Cased in., ft.

Sand

Gas

Oil

Total Depth 3521

PRODUCTION

1st 24 hrs. Nat.

1st 24 hrs. after shot

Gas Cu. Ft.

Dry Hole

Abandoned

Date

JAN 31 1945 19

S. J. LEWIS Scout

Pool Name Wildcat

Map No. 133 Sec. 34 Twp. 5 R. 19W

Well No. 1 Thayer

Skelly Company

FIRST REPORT Contractor

SE NE

SECTION PLAT

 Ft. from N. Line

330 Ft. from S. Line

330 Ft. from E. Line

 Ft. from W. Line

Phillips

Location

Rig up

Drilling and Remarks:

RECORD

Cased in., ft.

Sand

Gas

Oil

Total Depth

PRODUCTION

1st 24 hrs. Nat.

1st 24 hrs. after shot

Gas Cu. Ft.

Dry Hole

Abandoned

Date

NOV 8 1944 19

S. J. LEWIS Scout