



Section 3 Township 5 Range 20W
Well No. 5 Bowman
Company Helmerich & Payne

Sec. 3 Twp. 5 R. 20W
Well No. #5 Bowman Farm
Helmerich & Payne Company
Logan

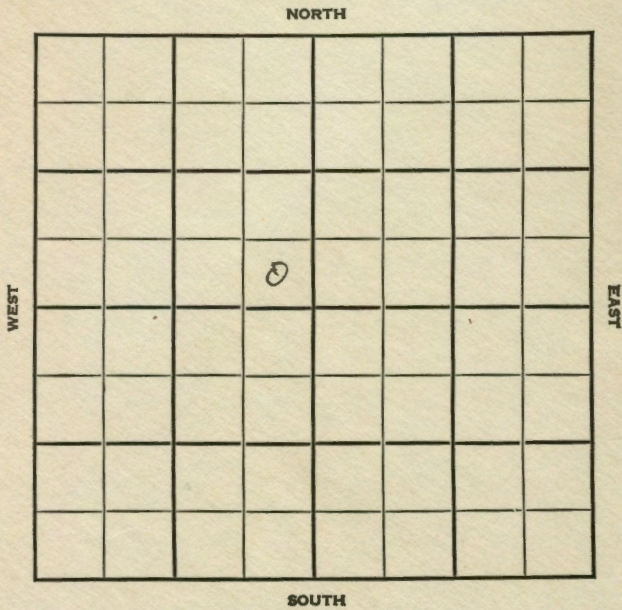

_____ Ft. from N. Line
330 Ft. from S. Line
330 Ft. from E. Line
_____ Ft. from W. Line

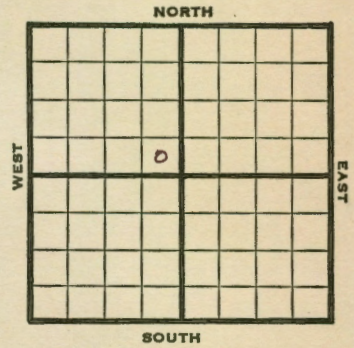

SE NW

1948 **Elev. 1973'** REPORT

- 4/28 10" @ 185'
WOC
- 5/5 Drlg. 3050'
- 5/12 **Lansing 3092'**
Arbuckle 3418'
TD 3421'
7" @ 3411'
RUST
- 5/19 TD 3439'
1600' Water
Squeeze
- 5/26 "
- 6/1 21 shots 3154-62 - 6W
trace oil squeeze
- 6/9 **Arb. 3418'**
7" @ 3411'
TD 3439'
Abd.

ABANDONED

6

Map No. 133 Sec. 3 Twp. 5 R. 20W

Well No. 5 Bowman

Helmerich & Payne Company

ABANDONED

Contractor

E. J. Lewis

SE NW

SECTION PLAT

Ft. from N. Line
330 Ft. from S. Line
330 Ft. from E. Line
Ft. from W. Line

| | | | |
|--|--|--|--|
| | | | |
| | | | |
| | | | |
| | | | |

Phillips County

Location _____

RECORD

Cased _____ in., _____ ft.
Sand _____
Gas _____
Oil _____
Total Depth 3439

Rig up _____

Drilling and Remarks:

cut 3418
7" @ 3411

PRODUCTION

1st 24 hrs. Nat. _____
1st 24 hrs. after shot _____
Gas _____ Cu. Ft.
Dry Hole _____
Abandoned _____

Date

JUN 9 1948 19

S. J. LEWIS Scout

Map No. _____ Sec. 3 Twp. 5 R. 20W

Well No. 5 Bowman

Helmerich & Payne Company

FIRST REPORT

Contractor

SE NW

SECTION PLAT

Ft. from N. Line
330 Ft. from S. Line
330 Ft. from E. Line
Ft. from W. Line

| | | | |
|--|--|--|--|
| | | | |
| | | | |
| | | | |
| | | | |

Phillips County

Location _____

RECORD

Cased _____ in., _____ ft.
Sand _____
Gas _____
Oil _____
Total Depth _____

Drilling and Remarks:

10" @ 185 WOC

PRODUCTION

1st 24 hrs. Nat. _____
1st 24 hrs. after shot _____
Gas _____ Cu. Ft.
Dry Hole _____
Abandoned _____

Date

APR 28 1948 19

S. J. LEWIS Scout