


FORM 51 5M PETROL

Section 3 Township 5 Range 20W
 Well No. 1 Copeland #1 Bowman "A"
 Company Helmerick & Payne et al

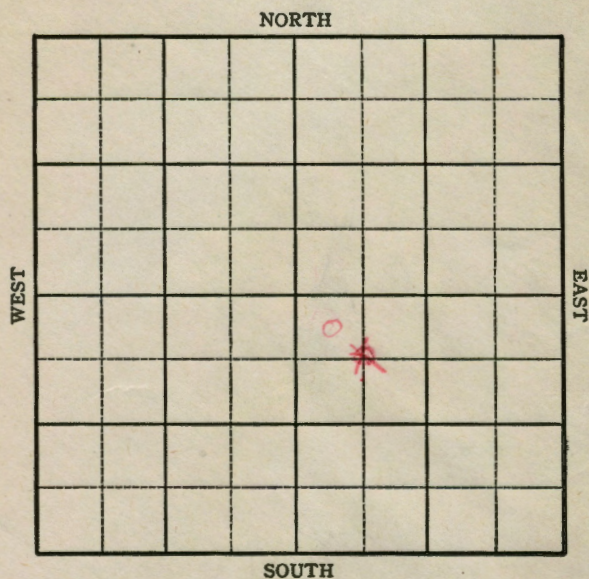


10

Sec. 3 Twp. 5 R. 20-W

Well No. #1 Copeland Bowman "A" Farm
Helmerick & Payne et al Company

330
~~660~~ Ft. from N. Line
 _____ Ft. from S. Line
 _____ Ft. from E. Line
330
~~660~~ Ft. from W. Line

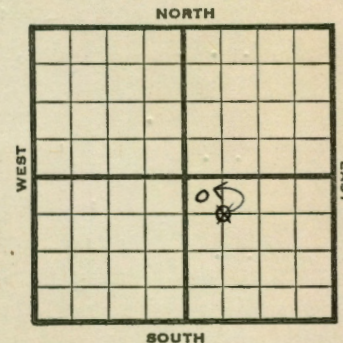

- NW SE

1945 Elev. 1976 REPORT

10/31	Location
11/7	"
11/14	M "
11/21	"
11/28	RUR
12/5	"
12/12	10" @ 155 Drlg. 1820'
12/20	Anhy 1940 Topeka 2841 Lans 3083 Drlg 3113
12/29	BKC 3300' 3/4 hour DST 3150-3200', 1630' oil. Sooy 3365' Arb 3372' T.D. 3452' SO. Run casing.
1946	
1/10	5" - 3552' 2000' water 1 hour.
1/17	P.B. to 3516' 5 shots 3460-65' 1800' water. P.B. to 3452'
1/24	P.B. 3422' 2 shots 3401-02' 225' oil 1 1/2 hours. 60 shots 3380-3402' Swab & oil per hour 48 hrs.
1/31	P.B. to 3400' 250 acid. HFW.
2/7	72 shots 3380-99' 250 acid. Swab 2 1/2 oil per hour 16 hours. 500 acid HFW. Squeeze.

OVER

1946

2/14

Plug 3192'

1 shot 3175', 1 shot 3176'

18 shots 3172-78' 500 acid.

H.F.O. 12 hours, S.W.

Swab 98 oil & 56 water in 6 hours.

Squeeze.

2/21

P.B. to 3179'

Swab 75 oil & 36 wtr in 8 hours.

PB to 3160'

2/28

P.B. to 3185'

12 shots 3172-76'

17 " 3149-56 2500' oil 4 hours.

Pump 75 oil in 8 hours.

Trace water.

3/6

Lans 3083

Arb. 3372

5" @ 3552

Perf. Lans.

TD 3552'

Pump 201 oil plus 15% wtr.

Grav. 37.4

COMPLETED

KANSAS Pool Name WildcatMap No. 133 Sec. 3 Twp. 5 R. 20WWell No. 1 CopelandHelmerick & Payne etal

Company

CORRECTION

Contractor

NW SE

SECTION PLAT

330 Ft. from N. Line

Ft. from S. Line

Ft. from E. Line

330

Ft. from W. Line

		0	

Phillips County

Location

RECORD

Cased in, ft.

Sand

Gas

Oil

Total Depth

Rig up

Drilling and Remarks:

reported

C NW SE

PRODUCTION

1st 24 hrs. Nat.

1st 24 hrs. after shot

Gas Cu. Ft.

Dry Hole

Abandoned

Date

NOV 7 1945 19S. J. LEWIS

Scout

KANSAS

Kansas

Pool Name WildcatMap No. 133 Sec. 3 Twp. 5 R. 20WWell No. 1 Bowman "A"Helmerick & Payne etal

Company

CORRECTION

Contractor

NW SE

SECTION PLAT

330 Ft. from N. Line

Ft. from S. Line

Ft. from E. Line

330

Ft. from W. Line

		0	

Phillips County

Location

RECORD

Cased in, ft.

Sand

Gas

Oil

Total Depth

Rig up

Drilling and Remarks:

reported as

#1 Copeland

PRODUCTION

1st 24 hrs. Nat.

1st 24 hrs. after shot

Gas Cu. Ft.

Dry Hole

Abandoned

Date

NOV 28 1945 19S. J. LEWIS

Scout

KANSAS

Kansas Pool Name LoganMap No. 133 Sec. 3 Twp. 5 R. 20WWell No. 1 Bowman "A"

Helmerick & Payne etal Company

COMPLETED

Contractor

NW SE

E11928
SECTION PLAT330 Ft. from N. Line

Ft. from S. Line

Ft. from E. Line

330 Ft. from W. Line

		0	

Phillips County

Location

Rig up

Drilling and Remarks:

Lease 3083Ac 33225 03552Prof. LeasingLease 20126 + 15 75 Water37 1/2

RECORD

Cased in. ft.

Sand

Gas

Oil

Total Depth 3552

PRODUCTION

1st 24 hrs. Nat.

1st 24 hrs. after shot

Gas Cu. Ft.

Dry Hole

Abandoned

Date

MAR 6 1946 19

S. J. LEWIS Scout

KANSAS

Kansas Pool Name WildcatMap No. 133 Sec. 3 Twp. 5 R. 20WWell No. 1 Copeland

Helmerick & Payne etal Company

FIRST REPORT

Contractor

C NW SE

SECTION PLAT

660 Ft. from N. Line

Ft. from S. Line

Ft. from E. Line

660 Ft. from W. Line

		0	

Phillips County

Location X

Rig up

Drilling and Remarks:

RECORD

Cased in. ft.

Sand

Gas

Oil

Total Depth

PRODUCTION

1st 24 hrs. Nat.

1st 24 hrs. after shot

Gas Cu. Ft.

Dry Hole

Abandoned

Date

OCT 3 1 1945

19

S. J. LEWIS

Scout