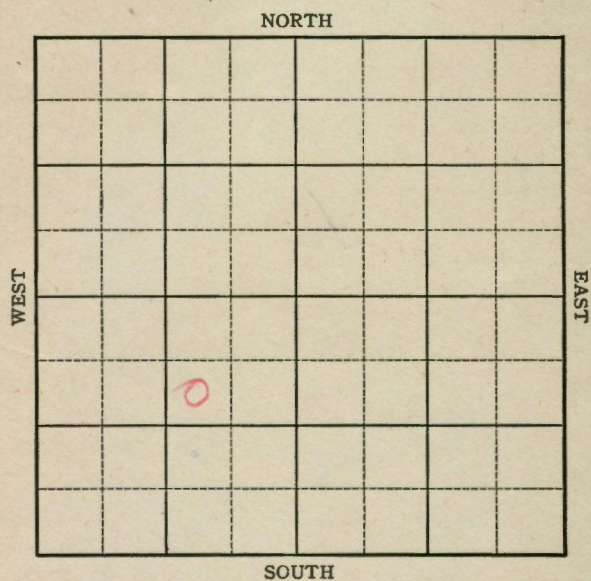


KANSAS

Phillips county

Section 3 Township 5 Range 20WWell No. #2, Bowman "A"Company Helmerich & Payne & TidewaterSec. 3 Twp. 5 R. 20WWell No. #2 Bowman "A" FarmHelmerich & Payne & Tidewater Company


Logan

990 Ft. from N. Line

Ft. from S. Line

990 Ft. from E. Line

Ft. from W. Line

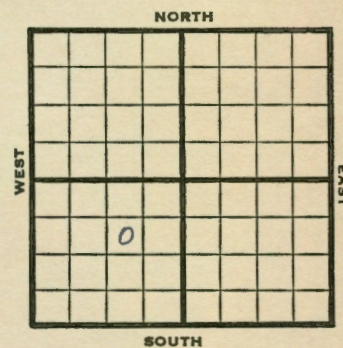

SW NE SW

1946

Elev. 1990

REPORT

4/17 Location

4/23 Loc.

5/1 10" @ 157 WOC

5/7 **Lans 3114**

VSSO 3156-66

3178-84, 3199-3208

Drlg 3220'5/14 **Arb 3408-14 TD**

5" @ 3408 RUST

5/21 TD 3418'

500 acid

5/29 TD 3419½'

450' oil

Pump 34 oil in 9 hrs.

6/5 **Arb. 3408**

5" @ 3408

500 acid.

TD 3419½'

Pump 90 Pot.

Grav. 27.0

COMPLETED

KANSAS Kansas Pool Name Logan Pool
 Map No. 133 Sec. 3 Twp. 5 R. 20W
 Well No. 2 Bowman "A"
Helmerich & Payne & Tidewater Company

COMPLETED

Contractor

SW NE SW

SECTION PLAT

990 Ft. from N. Line

Ft. from S. Line

990 Ft. from E. Line

Ft. from W. Line

E. 1. 1990

Phillips County

Location

Rig up

Drilling and Remarks:

*At 3408**5" C 3408**500 acid**Pump 90 Rod**27-94*

RECORD

Cased in ft.

Sand

Gas

Oil

Total Depth 3419 1/2

PRODUCTION

1st 24 hrs. Nat.

1st 24 hrs. after shot

Gas Cu. Ft.

Dry Hole

Abandoned

Date

JUN 5 1946

19

S. J. LEWIS

Scout

KANSAS Kansas Pool Name Logan
 Map No. 133 Sec. 3 Twp. 5 R. 20W
 Well No. 2 Bowman "A"
Helmerich & Payne & Tidewater Company

FIRST REPORT

Contractor

SW NE SW

SECTION PLAT

990 Ft. from N. Line

Ft. from S. Line

990 Ft. from E. Line

Ft. from W. Line

Phillips County

Location X

Rig up

Drilling and Remarks:

RECORD

Cased in ft.

Sand

Gas

Oil

Total Depth

PRODUCTION

1st 24 hrs. Nat.

1st 24 hrs. after shot

Gas Cu. Ft.

Dry Hole

Abandoned

Date

APR 17 1946

19

S. J. LEWIS

Scout