


Section 11 Township 5 Range 20-W

Well No. 1 Ross

Company Mallard Drlg. et al

Wildcat

NORTH

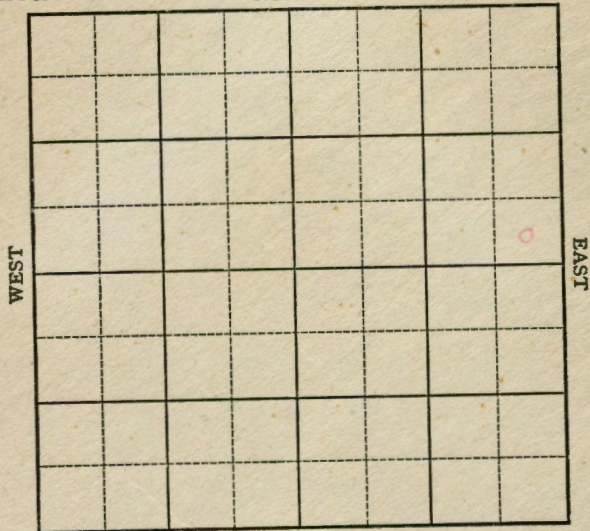

SOUTH

8

Sec. 11 Twp. 5 R. 20-W

Well No. #1 Ross Farm

Mallard Drlg. et al Company


Wildcat

\_\_\_\_\_ Ft. from N. Line

330 Ft. from S. Line

330 Ft. from E. Line

\_\_\_\_\_ Ft. from W. Line

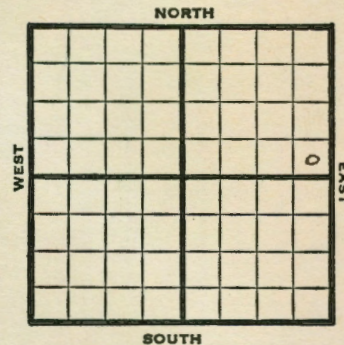

SE NE

1947

**Elev. 2019'** REPORT

7/9

Location

7-16

8" @ 155

Drlg. 1200

7/22

**Lansing 3152'**

Drlg 3507'

7/30

**Arb. 3616'**

TD 3644'

**ABANDONED**

Map No. 133 Sec. 11 Twp. 5 R. 20W

Well No. 1 Ross

Mallard Drlg. etal. Company

ABANDONED

Contractor

*E1,2019*

SE NE

SECTION PLAT

Ft. from N. Line  
330 Ft. from S. Line  
330 Ft. from E. Line  
Ft. from W. Line


Phillips County

Location \_\_\_\_\_

Rig up \_\_\_\_\_

Drilling and Remarks:

*Ar 3616*

RECORD

Cased \_\_\_\_\_ in., \_\_\_\_\_ ft.

Sand \_\_\_\_\_

Gas \_\_\_\_\_

Oil \_\_\_\_\_

Total Depth 3644

PRODUCTION

1st 24 hrs. Nat. \_\_\_\_\_

1st 24 hrs. after shot \_\_\_\_\_

Gas \_\_\_\_\_ Cu. Ft.

Dry Hole \_\_\_\_\_

Abandoned \_\_\_\_\_

Date

JUL 30 1947 19

S. J. LEWIS

Scout

Map No. \_\_\_\_\_ Sec. 11 Twp. 5 R. 20W

Well No. 1 Ross

Mallard Drlg. etal. Company

FIRST REPORT

Contractor

SE NE

SECTION PLAT

Ft. from N. Line  
330 Ft. from S. Line  
330 Ft. from E. Line  
Ft. from W. Line


Phillips County

Location X \_\_\_\_\_

Rig up \_\_\_\_\_

Drilling and Remarks:

RECORD

Cased \_\_\_\_\_ in., \_\_\_\_\_ ft.

Sand \_\_\_\_\_

Gas \_\_\_\_\_

Oil \_\_\_\_\_

Total Depth \_\_\_\_\_

PRODUCTION

1st 24 hrs. Nat. \_\_\_\_\_

1st 24 hrs. after shot \_\_\_\_\_

Gas \_\_\_\_\_ Cu. Ft.

Dry Hole \_\_\_\_\_

Abandoned \_\_\_\_\_

Date

JUL 9 1947 19

S. J. LEWIS

Scout