



Section 8 Township 5 Range 20W
 Well No. 1 Miller
 Company J. W. BRADEN

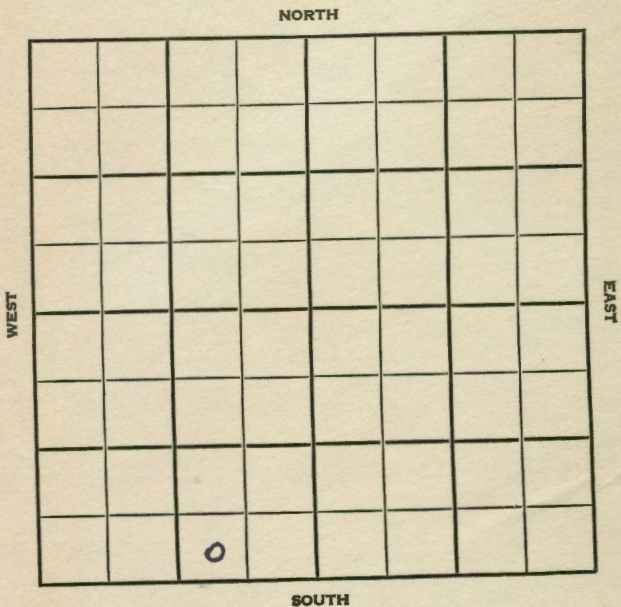

14

SEC. 8 TWP. 5 R. 20 W
 WELL NO. # 1 Miller FARM
 COMPANY J. W. Braden
 CONTRACTOR Co. tools

Wildcat
 _____ Ft. from N. Line
330 _____ Ft. from S. Line
990 _____ Ft. from E. Line
 _____ Ft. from W. Line

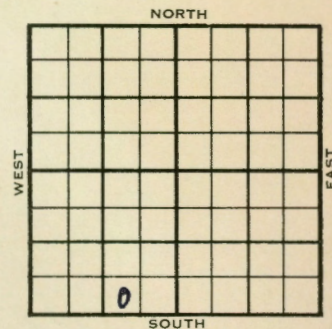

SW SE SW

Phillips FO & DHM

	ELEVATION	REPORT
1955	2082'	
1/12	Spud 1-9-55 8" @ 241	
1/19	Spud 1-9-55 D & A TD 3600' 8" @ 241'	
	Heeb 3243' Tor. 3277' Lans 3289' Marm 3482' Arb. 3534'. DST 3539'-44' opn 1/2 hr, rec 3' Mud 355# TD 3600' D & A	

ABANDONED

