


Section 10 Township 5 Range 20W

Well No. 1 Wilttrout

Company Musgrove Pet.

NORTH

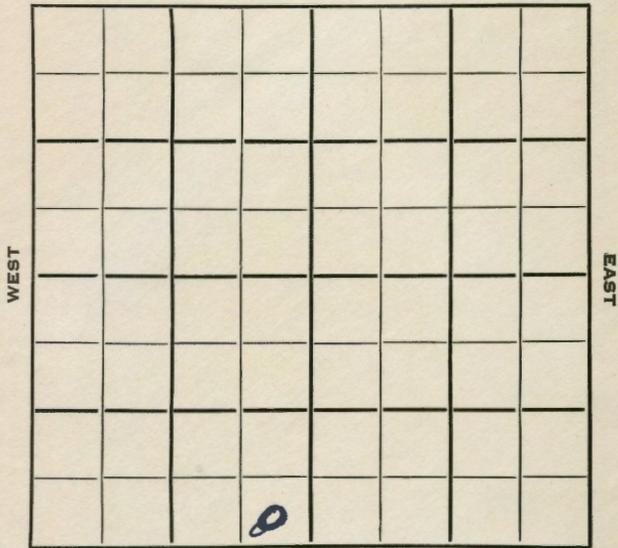

SOUTH

14

Sec. 10 Twp. 5 R. 20 W

Well No. # 1 Wilttrout Farm

Musgrove Pet. Company

Musgrove

Wildcat

Ft. from N. Line


330 Ft. from S. Line

330 Ft. from E. Line

Ft. from W. Line

SE SE SW  
Skelly DHM

NORTH

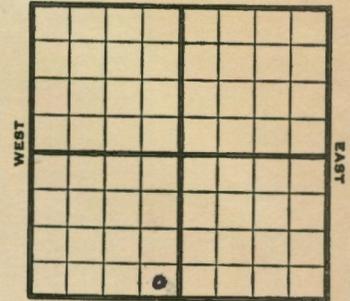

SOUTH

1952 Elev. 2060' REPORT

12/10 Spud 12-5-52  
 8" @ 185 Anhy 1600'  
 Drlg. 2209'

12/18 Heeb 3188 Tor 3212 KC 3230 BKC 3431  
 Ø 3510

12/23 Spud 12-5-52 D & A TD 3525'  
 8" @ 185 Anhy 1600' Heeb 3188'  
 Tor. 3212' KC 3230' B KC 3431'  
 TD 3525'  
 D & A

ABANDONED

1953  
1/14

ADDITIONAL INFORMATION

Completed 12-23-52  
 Cong. 3499' Gorham 3507'  
 Arb. 3509'  
 TD 3525' D & A

ABANDONED

Map No. \_\_\_\_\_ Sec. 10 Twp. 5 R. 20W

Well No. 1 Wiltout

Musgrove Pet. \_\_\_\_\_ Company

\_\_\_\_\_ Contractor

SE SE SW


SECTION PLAT

\_\_\_\_\_ Ft. from N. Line

330 Ft. from S. Line

330 Ft. from E. Line

\_\_\_\_\_ Ft. from W. Line

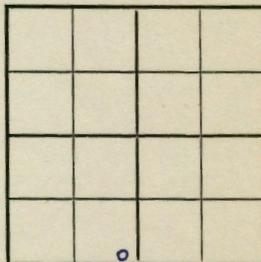

Phillips County

Location \_\_\_\_\_

RECORD

Cased \_\_\_\_\_ in., \_\_\_\_\_ ft.

Rig up \_\_\_\_\_ Sand \_\_\_\_\_

Drilling and Remarks: \_\_\_\_\_ Gas \_\_\_\_\_

\_\_\_\_\_ Oil \_\_\_\_\_

\_\_\_\_\_ Total Depth \_\_\_\_\_

Additional information

Completed 12-23-52

Cong. 3499

Gorham 3507

Arb. 3509

TD 3525

D & A

PRODUCTION

1st 24 hrs. Nat. \_\_\_\_\_

1st 24 hrs. after shot \_\_\_\_\_

Gas \_\_\_\_\_ C \_\_\_\_\_

Dry Hole \_\_\_\_\_

Abandoned \_\_\_\_\_

Date

JAN 14 1953 19

J. G. McGEH

