

KANSAS

FORM 51 IOM 12-46 PETROL

Phillips Co.


Section 11 Township 5 Range 20-W

Well No. 1 Lappin

Company Geo. Johnson et al

Wildcat

NORTH

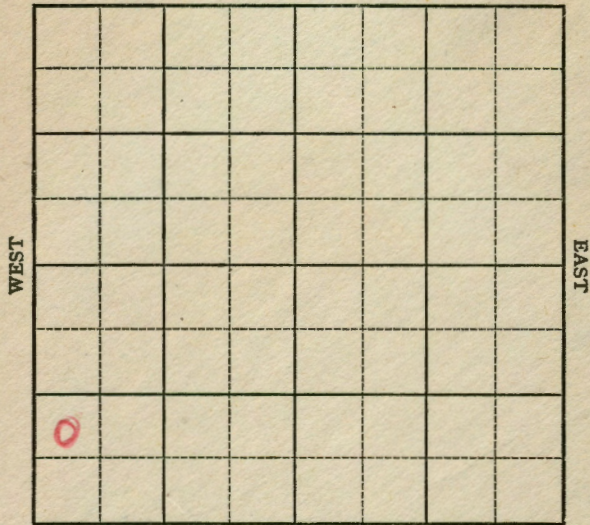

SOUTH

13

SM 12-46 PETROL

KANSAS

Sec. 11 Twp. 5 R. 20-W

Well No. #1 Lappin Farm _____

Company Geo. Johnson et al

Wildcat

_____ Ft. from N. Line

990


_____ Ft. from S. Line

_____ Ft. from E. Line

330

_____ Ft. from W. Line

NW SW SW

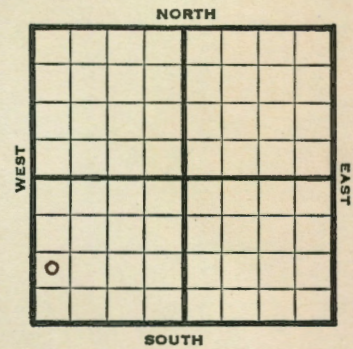

1947

El. 2038'

REPORT

7/1

Location

7/8

8" @ 150'

Drlg 1320'

7/23

Arbuckle 3462'

5" @ 3462'

T.D. 3473'

7/29

"

8/6

Arbuckle 3462'

5" @ 3462'

T.D. 3473'

Abandoned

ABANDONED

Map No. 133 Sec. 11 Twp. 5 R. 20W

Well No. 1 Lappin

Geo. Johnson et al. Company

ABANDONED Contractor

NW SW SW

E12088
SECTION PLAT

| | | | |
|--|--|--|--|
| | | | |
| | | | |
| | | | |
| | | | |

Ft. from N. Line

990 Ft. from S. Line

Ft. from E. Line

330 Ft. from W. Line

Phillips County

Location _____

Rig up _____

Drilling and Remarks:

CEX 3462
5" @ 3462

RECORD

Cased _____ in., _____ ft.

Sand _____

Gas _____

Oil _____

Total Depth 3472

PRODUCTION

1st 24 hrs. Nat. _____

1st 24 hrs. after shot _____

Gas _____ Cu. Ft.

Dry Hole _____

Abandoned _____

Date

AUG 6 1947 S. J. LEWIS Scout

Map No. _____ Sec. 11 Twp. 5 R. 20W

Well No. 1 Lappin

Geo. Johnson et al. Company

FIRST REPORT Contractor

NW SW SW

SECTION PLAT

| | | | |
|--|--|--|--|
| | | | |
| | | | |
| | | | |
| | | | |

Ft. from N. Line

990 Ft. from S. Line

Ft. from E. Line

330 Ft. from W. Line

Phillips County

Location X

Rig up _____

Drilling and Remarks:

RECORD

Cased _____ in., _____ ft.

Sand _____

Gas _____

Oil _____

Total Depth _____

PRODUCTION

1st 24 hrs. Nat. _____

1st 24 hrs. after shot _____

Gas _____ Cu. Ft.

Dry Hole _____

Abandoned _____

Date

JUL 2 1947 S. J. LEWIS Scout