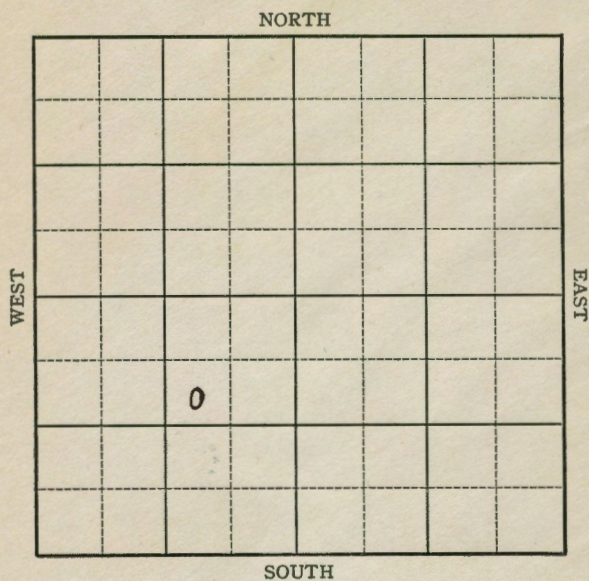


KANSAS

Phillips

FORM 51 5M 1-42 PETROL

Section 14 Township 5 Range 20-WWell No. #2 TempletonCompany Citites Service Oil

11

FORM 252-A
5M 9-42 GASS**KANSAS**

Phillips

Sec. 14 Twp. 5 R. 20-WWell No. #2 Templeton FarmCities Service Oil Company


Ray

990 Ft. from N. Line

Ft. from S. Line

990 Ft. from E. Line

Ft. from W. Line

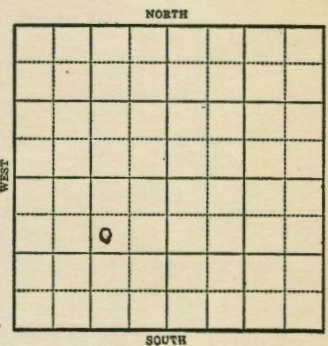Elev. 2134

1943

REPORT

6/2

Derrick

6/9

8" @ 158'
Drilg. 2893'

6/16

Lans 3238
 SO 3245-48, 3253-59 3270-76
 Re Arb 3500
 Arb 3514
 Cat. 3515-20
 T.D. 3630
 5" @ 3630 RUST.

6/23

59 shots 3579-91 water
 shot 3509-14,
 60 shots 3512-22
 48 shots 3522to 30

6/30

" " " "

7/7

118 shots 3511-30-2000 acid
 Swab 37 oil in 8 hrs.

7/14

Arb. 3514'
 5" @ 3630'
 T.D. 3630'
 Perf. pipe in Arb
 4000 acid
 Pump 148 Pot.
 Gravity 35

COMPLETED

KANSAS
Map No. 133 Sec. 14 Twp. 5 R. 20W

Well No. 2 Templeton

Cities Service Oil

Company

COMPLETED

Contractor

SW NE SW


SECTION PLAT

990 Ft. from N. Line

Ft. from S. Line

990 Ft. from E. Line

Ft. from W. Line

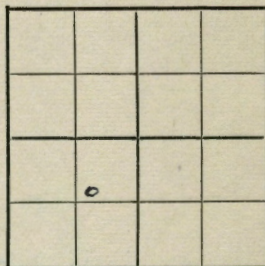

RAY POOL

Location

Rig up

Drilling and Remarks:

*Cur 8 3514**5" @ 3630**Prof. pipe in oil**4000 acid**Pump 148 Bx**3.5 c/hr*

RECORD

Cased in. ft.

Sand

Gas

Oil

Total Depth *3630*

PRODUCTION

1st 24 hrs. Nat.

1st 24 hrs. after shot

Gas Cu. Ft.

Dry Hole

Abandoned

Date

JUL 14 1943 19

S. J. LEWIS Scout

KANSAS
Map No. 133 Sec. 14 Twp. 5 R. 20W

Well No. 2 Templeton

Cities Service Oil

Company

FIRST REPORT

Contractor

SW NE SW


SECTION PLAT

990 Ft. from N. Line

Ft. from S. Line

990 Ft. from E. Line

Ft. from W. Line

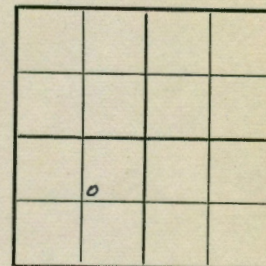

RAY POOL

Location

Rig up

Drilling and Remarks:

DERRICK

RECORD

Cased in. ft.

Sand

Gas

Oil

Total Depth

PRODUCTION

1st 24 hrs. Nat.

1st 24 hrs. after shot

Gas Cu. Ft.

Dry Hole

Abandoned

Date

JUN 2 1943 19

S. J. LEWIS Scout