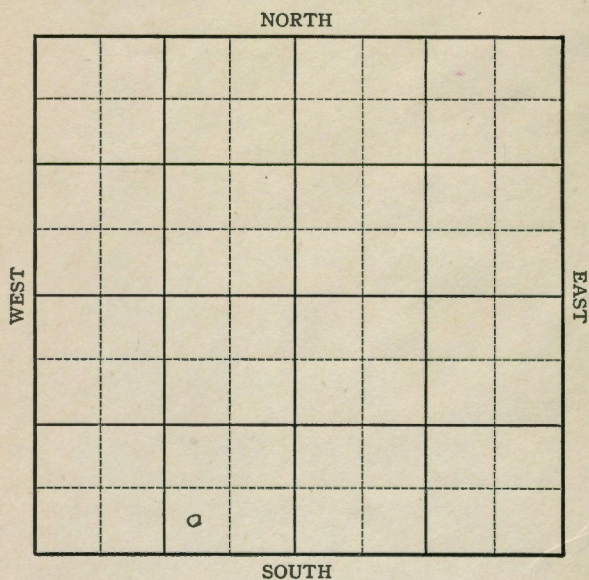


KANSAS

FORM 51 5M 1-42 PETROL

Phillips

Section 14 Township 5 Range 20-WWell No. #1 TempletonCompany Cities Service Oil

14

FORM 252-A
5M 9-42 GASS

KANSAS

Phillips


Sec. 14 Twp. 5 R. 20-WWell No. #1 Templeton FarmCities Service Oil Company

Ray

Ft. from N. Line

330 Ft. from S. Line990 Ft. from E. Line

Ft. from W. Line

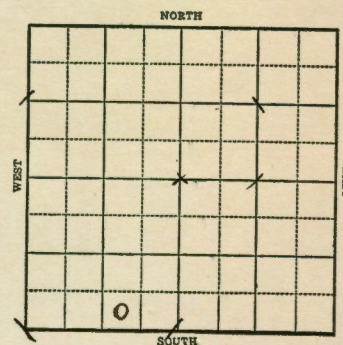Elev. 2160

1943

REPORT

3/24

Location

4/7

8" @ 157'
Drlg. 3185'

4/7

Anhy 1650
Topeka 3090
Lans 3298
Arb 3522
3529-33 Good
Poro & sat.
Reagan 3672
Granite Wash 3712

T.D. 3772

4/21

5" @ 3772 RUST.

4/28

" " "

5/5

Arb 3530 Corrected
Reagan 3680
Granite Wash. 3720
5" @ 3780 T.D.

24 shots 3597-3601
2000(oil 34 hrs.

5/12

1000 acid Pump 12 fluid per hr
6 hrs 95% water.

5/22

PB 3575 WOC.

OVER

1943

5/26 120 shots 3520-40-3000 acid
swab 8 bbls oil in 2 hrs.

6/2 36 shots 3514-20
35 shots 3440-46
2000 acid Swb 82 fluid in 8 hrs
9% BS & W

6/9 Lens 3298
Arb. 3530
Granite Wash 3720
Reagan 3680
5" @ 3780
Perf. Arb.
T.D. 3780'
2,000 gal acid.
Pump 383 Pot.
Gravity 35

COMPLETED

KANSAS

Phillips

Map No. 133 Sec. 14 Twp. 5 R. 20WWell No. 1 Templeton

Cities Service Oil

Company

COMPLETED

Contractor

SW SE SW


SECTION PLAT

Ft. from N. Line

330 Ft. from S. Line

990 Ft. from E. Line

Ft. from W. Line

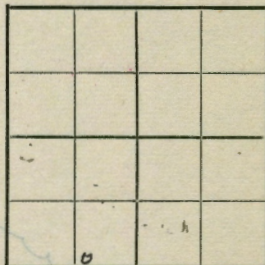

RAY POOL

Location

RECORD

Cased in, ft.

Rig up

Sand

Drilling and Remarks:

Gas

Oil

Total Depth 3780

PRODUCTION

1st 24 hrs. Nat.

1st 24 hrs. after shot

Gas Cu. Ft.

Dry Hole

Abandoned

Date

JUN 9 1943 19

S. J. LEWIS

Scout

KANSAS

Phillips

Map No. 133 Sec. 14 Twp. 5 R. 20WWell No. 1 Templeton

Cities Service Oil

Company

FIRST REPORT

Contractor

SW SE SW


SECTION PLAT

Ft. from N. Line

330 Ft. from S. Line

990 Ft. from E. Line

Ft. from W. Line

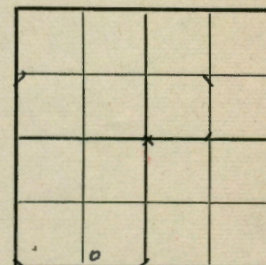

RAY POOL

Location

XXXX

RECORD

Cased in, ft.

Rig up

Sand

Drilling and Remarks:

Gas

Oil

Total Depth

PRODUCTION

1st 24 hrs. Nat.

1st 24 hrs. after shot

Gas Cu. Ft.

Dry Hole

Abandoned

Date

MAR 24 1943 19

S. J. LEWIS

Scout