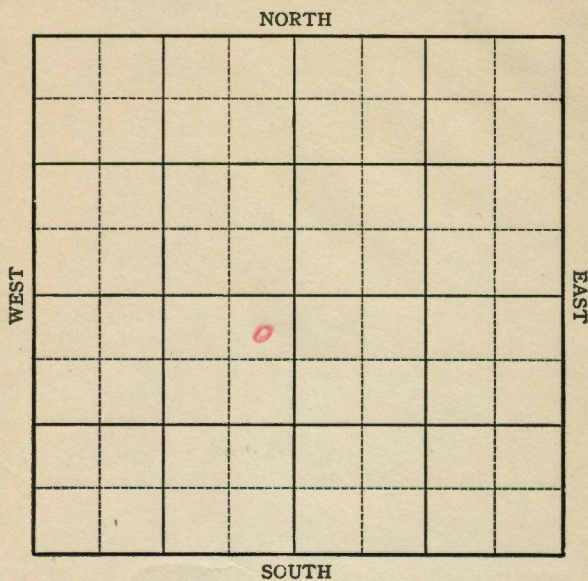


Phillips county

KANSAS

Section 14 Township 5 Range 20-WWell No. #5, TempletonCompany Cities Service Oil Company

5M 6-46 PETROL

KANSAS Phillips ✓

Sec. 14 Twp. 5 R. 20WWell No. #5 Templeton Farm

Cities Service Company


Hansen Pool

330 Ft. from N. Line

Ft. from S. Line

330 Ft. from E. Line

Ft. from W. Line

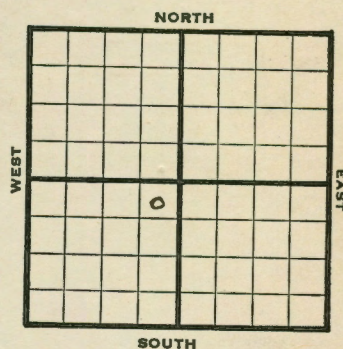

NE SW

1946 Elev. 2128 REPORT

10/23	Location
10/29	"
11/6	8" @ 192'
	Drlg 3106'
11/12	Lans 3232'
	BKC 3437'
	Arb 3495'
	TD 3504-
	5" @ 3502, RUST
11/20	48 shots 3296-3311
	250 acid,
	Pump 99 oil & 19% wtr.
11/27	Sqz Perf
12/1	27 shots 3297-3309'
	2000 acid, pump 180 fluid
	80% W 24 hrs, squ.
12/10	" " "
12/17	" " "
1947	
1/4	1000 acid, 3319 to 25
	Pump 94 fluid in 22 hrs
	36% W
1/8	" " "
1/15	" " "
1/21	" " "

OVER

1/29 Lens 3232
Arb 3495
5" @ 3502
Perf Lens
1000 acid
Pump 32 oil to 38% W Pot
33 Gr.
TD 3504'

COMPLETED

Map No. 133 Sec. 14 Twp. 5 R. 20WWell No. 5 Templeton

Cities Service

Company

COMPLETE

Contractor


NE SW

E1,2,128
SECTION PLAT330 Ft. from N. Line

Ft. from S. Line

330 Ft. from E. Line

Ft. from W. Line

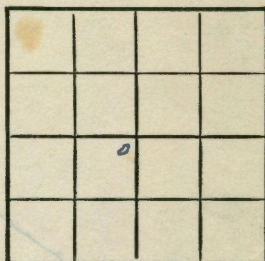

Phillips County

Location

RECORD

Cased in. ft.

Sand

Gas

Oil

Total Depth 3504

PRODUCTION

1st 24 hrs. Nat.

1st 24 hrs. after shot

Gas Cu. Ft.

Dry Hole

Abandoned

Date

JAN 29 1947 19 S. J. LEWIS Scout

Drilling and Remarks:

Log 3232Log 34955" @ 3502Per Liana
10000000Pump 32 oil 73875W.B.A.Map No. 133 Sec. 14 Twp. 5 R. 20WWell No. 5 Templeton

Cities Service

Company

FIRST REPORT

Contractor

NE SW


SECTION PLAT

330 Ft. from N. Line

Ft. from S. Line

330 Ft. from E. Line

Ft. from W. Line

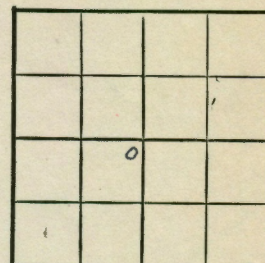

Phillips County

Location

RECORD

Cased in. ft.

Sand

Gas

Oil

Total Depth

PRODUCTION

1st 24 hrs. Nat.

1st 24 hrs. after shot

Gas Cu. Ft.

Dry Hole

Abandoned

Date

OCT 23 1946 19 S. J. LEWIS Scout

Rig up

Drilling and Remarks: