


KANSAS

Phillips

Section 14 Township 5 Range 20WWell No. #6 TempletonCompany Cities Service

NORTH

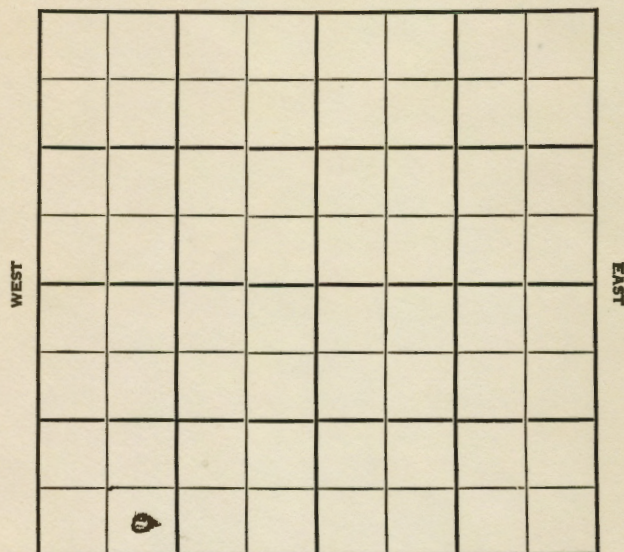

SOUTH

13

KANSAS

Phillips

✓

Sec. 14 Twp. 5 R. 20WWell No. #6 Templeton Farm

Cities Service Company

Hansen Pool


Ft. from N. Line

330' Ft. from S. Line

Ft. from E. Line

990' Ft. from W. Line

SE SW SW

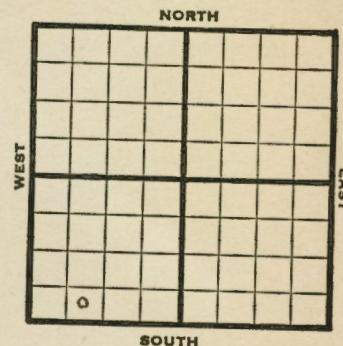

1948 Elev. 2139' REPORT

2/4 8" @ 150'
Drlg. 1893'2/11 Lansing 3249'
Arbuckle 3512-48' TD
5" @ 3542'
RUST2/18 TD 3579'
2/3 Bailer oil PH2/25 500 acid, no help
16 shots 3536-40
22 " 3510-16-500 acid
Pump 20 bbls oil & 4 W PH, 24 hrs.
3/3 Pump 28 bbls oil & 3 W in 20 hrs.

3/10 "

3/17 "

3/24 "

3/31 "

4/7 "

4/14 Lans. 3249' Arb. 3512'
5" @ 3542'
Perf. Arb. 500 acid.
Pump 43 oil / 10% W pot.
27.0 Gr.
TD 3579'
Comp.

COMPLETED

Map No. 133 Sec. 14 Twp. 5 R. 20WWell No. 6 Templeton

Cities Service Company

COMPLETE Contractor

SE SW SW

SECTION PLAT
27.2 N 8

Ft. from N. Line

330 Ft. from S. Line

Ft. from E. Line

990 Ft. from W. Line

Phillips County

Location

Rig up

Drilling and Remarks:

*Base 3249**At 3512**5' @ 3542**Per At**Found oil + 10% water*

Date

APR 14 1948 19 S. J. LEWIS Scout

RECORD

Cased in, ft.

Sand

Gas

Oil

Total Depth 3528

PRODUCTION

1st 24 hrs. Nat.

1st 24 hrs. after shot

Gas Cu. Ft.

Dry Hole

Abandoned

Map No. Sec. 14 Twp. 5 R. 20W

Well No. 6 Templeton

Cities Service Company

FIRST REPORT Contractor

SE SW SW

SECTION PLAT

Ft. from N. Line

330 Ft. from S. Line

Ft. from E. Line

990 Ft. from W. Line

Phillips County

Location

Rig up

Drilling and Remarks:

8" @ 150

drlg. 1893

Date

FEB 4 1948 19 S. J. LEWIS Scout

RECORD

Cased in, ft.

Sand

Gas

Oil

Total Depth

PRODUCTION

1st 24 hrs. Nat.

1st 24 hrs. after shot

Gas Cu. Ft.

Dry Hole

Abandoned