



FORM 51 25M 3-49 PETROL Phillips KANSAS
Section 14 Township 5 Range 20W
Well No. #8 Templeton
Company Cities Service Oil

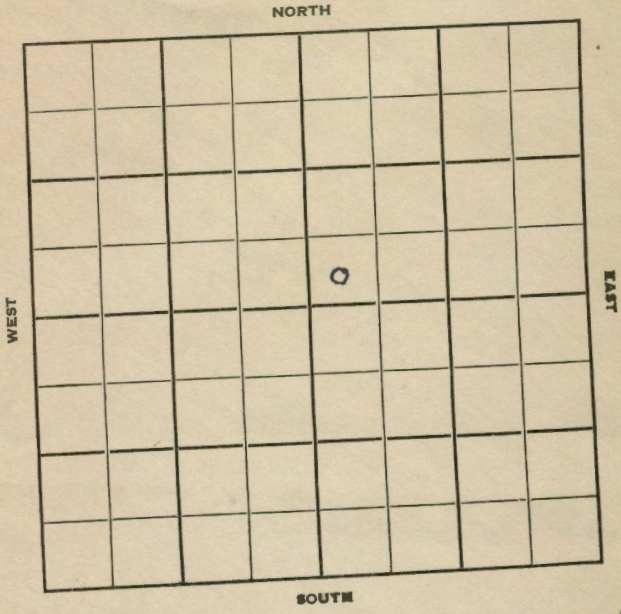

7

FORM 252-B Phillips KANSAS
Sec. 14 Twp. 5 R. 20W
Well No. #8 Templeton Farm
Cities Service Oil Company
Rein Drlg. Contractor

Ft. from N. Line
330 Ft. from S. Line
Ft. from E. Line
330 Ft. from W. Line
NE 1/4 SW SW NE

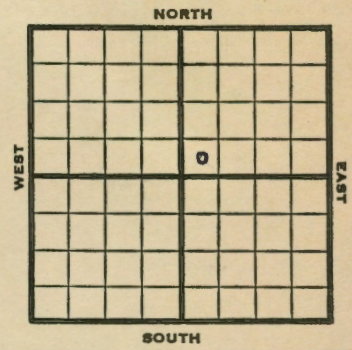

1952	Elev. 2150' REPORT
11/5	Spud 11-2-52 8" @ 202'
11/12	Drlg. 3455'
11/20	Heeb 3222' Dodge 3245' Lans 3265' B KC 3467' Arb. 3535' RTD 3542' 5" @ 3537' CO
11/27	CO 3542 P/27 BO 18 hrs., 1000A P/1 BOPH + 2% wtr.
12/4	NR
12/11	NR
12/17	Spud 11-2-52 Oil well TD 3542 8" @ 202 Heeb 3222, Dodge 3245, Lans 3265, B KC 3467, Arb. 3535 TD 3542 5" @ 3537 CO to 3542 P/27 bo 18 hrs., 1000A P/1 boph 2% wtr Comp. 36 bopd

COMPLETED

J. G. McGEHEE

J. G. McGEHEE