


Section 14 Township 5 Range 20 W
 Well No. # 9 Templeton
 Company Cities Service Oil

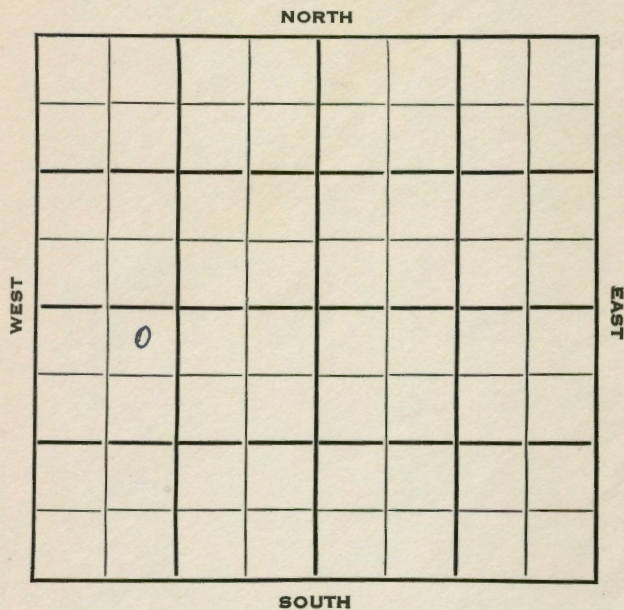


12

SEC. 14 TWP. 5 R. 20W ✓
 WELL NO. 9 Templeton
 COMPANY Cities Service Oil FARM

CONTRACTOR

Nye Drlg.
Hansen Pool

330 Ft. from N. Line
 _____ Ft. from S. Line
 _____ Ft. from E. Line
990 Ft. from W. Line

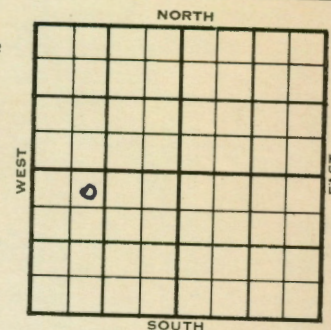

NE NW SW

1953 ELEVATION 2103' REPORT

12/16
 1954
 1/13

Location

Spud 12-17-53
 Oil Well
 TD 3497'
 8" @ 190'

Heeb 3177', Dodge 3202', Lans 3219'
 DST 3230'-45' opn 1 hr, rec 435' gas,
 125' oil, 10' ocm 120#
 DST 3253'-60' opn 1 hr, rec 181' mud
 & wtr. 400#
 DST 3290'-3317' opn 1 hr, rec 30' Mud
 230# B KC 3425', Gorham 3479', Arb
 3485'

TD 3497'
 5" @ 3489'
 CO to 3497'
 FU 1260' oil 16 hr.
 1000 A Comp 265 bopd.

COMPLETED

County Phillips State Kansas
 Sec. 14 (Bk. 5 (Sur. 20W Map No.
 Operator Cities Service Oil
 Well No. 9 Farm Templeton
 Elev. 2103 Location NE NW SW

330 Ft. From N Line SW
990 Ft. From W Line Quarter
 1st. Report
 Completion JAN 13 1954
 Remarks Hansen Pool
Nye Drlg. - Contr.
 Spudding Date 12-17-53

Drlg. Data Oil well TD 3497
8" @ 190 Heeb. 3177 Dodge 3202
Lans. 3219 DST 3230-45 open 1 hr.
Rec. 435' gas 125' oil 10' ocm 120#
DST 3253-60 open 1 hr. Rec. 181' mud &
wtr. 400# DST 3290-3317 open 1 hr.
Rec. 30' mud 230# B KC 3425
Gorham 3479 Arb. 3485 TD 3497
5" @ 3489 CO to 3497 FU 1260' oil 16 ht
1000A Comp. 265 bopd

J. G. McGEHEE

County Phillips State Kansas
 Sec. 14 (Bk. 5 (Sur. 20W Map No.
 Operator Cities Service Oil
 Well No. 9 Farm Templeton
 Elev. Location NE NW SW

330 Ft. From N Line SW
990 Ft. From W Line Quarter
 1st. Report DEC 16 1953
 Completion
 Remarks
Nye Drlg. - Contr.
 Spudding Date

Drlg. Data Hansen Pool

Location

J. G. McGEHEE