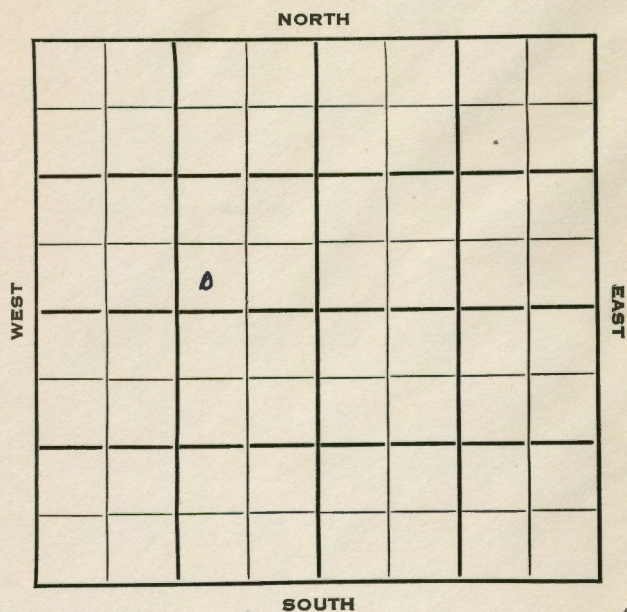


ANSIONS

Section 14 Township 5 Range 20WWell No. #10 TempletonCompany Cities Service

6

KANSAS

SEC. <u>14</u>	TWP. <u>5</u>	R. <u>20W</u>
----------------	---------------	---------------

WELL NO. #10 Templeton FARM

COMPANY Cities Service

CONTRACTOR L & J Drlg.

Hansen Pool

_____ Ft. from N. Line

330 _____ Ft. from S. Line

990 _____ Ft. from E. Line

_____ Ft. from W. Line

SW SE NW

WEST

EAST

NORTH

SOUTH

	ELEVATION	REPORT
1954	2098'	
4/7	Location	
4/14	"	
5/12	Spud 4-14-54 Oil well TD 3495 8" @ 200 Heeb 3177 Tor. 3204 Lans. 3221 DST 3222-40 open 1 hr rec 12' mud 100# DST 3297-3317 open 1/2 hr rec 5' mud Gorham 3478 Arb. 3488 TD 3494 5" @ 3489 DD 3495 32 GOPH 1000 A P/96 BO 3 BW 24 hr. Comp. 103 BOPD	

COMPLETED

J. G. McGEHEE

J. G. McGEHEE