

Section 15 Township 5 Range 20W

Sec. 15 Twp. 5 R. 20W

Well No. #1 Graham

Well No. #1 Graham Farm

Company D.G. Hansen

D.G. Hansen Company

C & G Drlg. Contractor

Ray Pool



Ft. from N. Line

330 Ft. from S. Line

Ft. from E. Line

990 Ft. from W. Line

SE SW NE

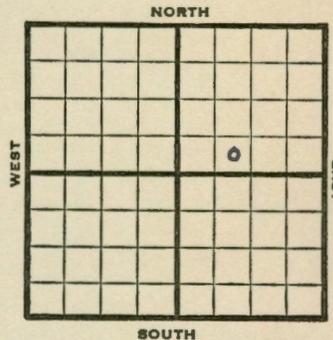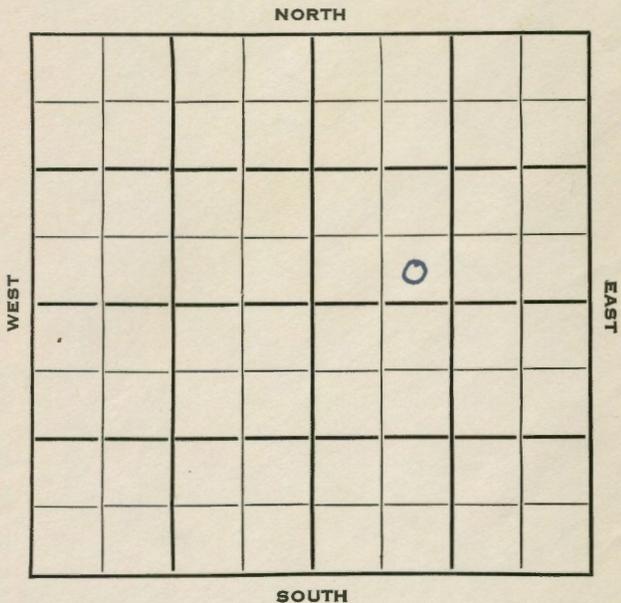

1953 **Elev. 2127'** REPORT

5/6
5/20

Cellar & Pits
 Spud 5-6-53
 D & A TD 3573 8" @ 195
Anhy 1652' Heeb 3238 Tor. 3261
Lans 3280 B KC 3484 Arb. 3558
 DST 3559-65 open 1 hr rec 45' OCM O#
 DST 3561-73 open 1 hr. rec 85' SOCM
 & wtr. 200#
 D & A

ABANDONED

7

