


Section 15 Township 5 Range 20W

Well No. #1 Hansen "FW"

Company Cities Service

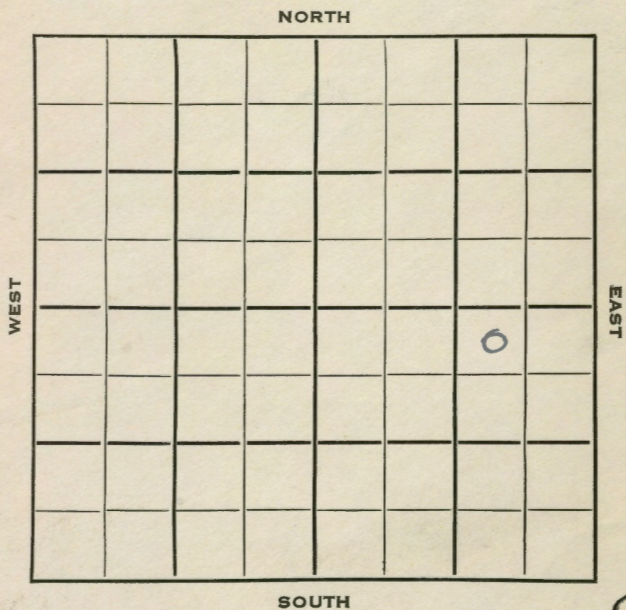

9

Sec. 15 Twp. 5 R. 20W

Well No. #1 Hansen "FW" Farm

Cities Service Company


Rine Drlg. Contractor
Hansen Pool

330 Ft. from N. Line

Ft. from S. Line

990 Ft. from E. Line

Ft. from W. Line
NW NE SE

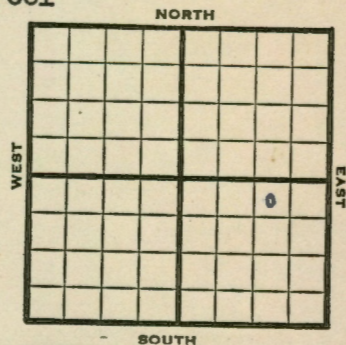

1953 Elev. 2122' REPORT

4/29 Spud 4-26-53
8" @ 200'
Drlg 1965'

5/7 5" set @ ?

5/20 Spud 4-26-53 Oil well TD 3537
8" @ 200 Heeb 3226 Dodge 3248
Lans 3269
DST 3250-78 open 1 hr. rec 22' mud
600# DST 3299-3325 open 1 hr rec 210
SW. 640# DST 3336-72 open 1 hr,
rec 10' mud, 560# B KC 3469
Gorham 3521' Arb. 3530'
TD 3534' 5" @ 3532 DD 3537
P/12 BO 6 BWPD 500 A P/22 BO 21 BW
9 hr.
Comp. 87 BOPD 38 BW

COMPLETED

