


Section 15 Township 5 Range 20W

Well No. #1 Lappin

Company Stearns Drlg. Co.

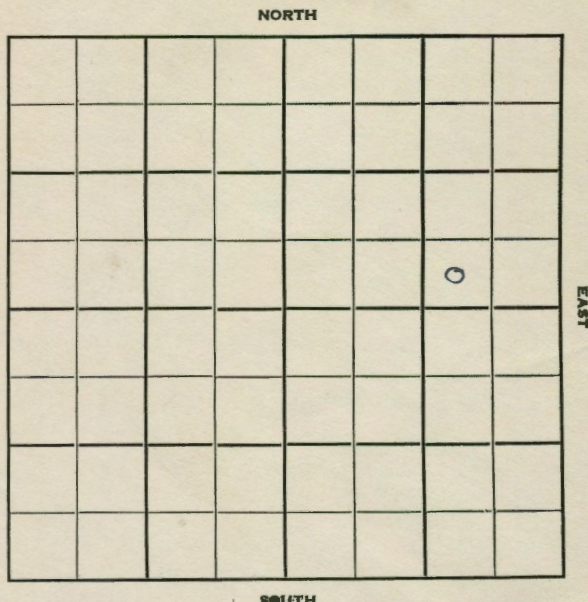

8


Sec. 15 Twp. 5 R. 20W

Well No. #1 Lappin Farm

Stearns Drlg. Co. Company

Stearns Wildcat Contractor

\_\_\_\_\_ Ft. from N. Line  
330 Ft. from S. Line  
990 Ft. from E. Line  
 \_\_\_\_\_ Ft. from W. Line  
 SW SE NE

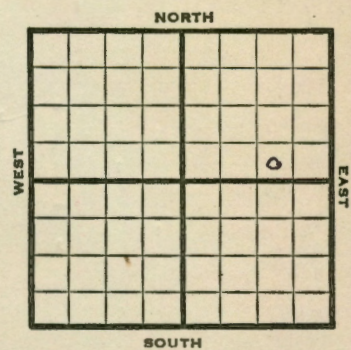

1952	Elev. 2129' REPORT
8/20	Spud 8-15-52 8" @ 181' w/125 sks. Anhy 1662' Drlg. 2630'
8/27	Arb. 3535 DST 3532-54½ hr. 110' hvy O&GCM 930# 15" 2 DST failed DST 3542-54 1½ hrs 480' gas 80' oil 20 hvy O&GCM
9/3	Heeb. 3240 Tor. 3262 Lans. 3280 DST 3264-88, 1/4 hr. 9'm & VSSO 1080# BKC 3480 Arb. 3535
9/10	CO 3554' TD Fill up 700' oil S/7 BOPH. Rung tubing.
9/17	NR
9/24	P#6
10/1	"
10/8	NR
10/15	"
10/22	"
10/29	"
11/5	"
11/12	"
11/20	"

OVER

1952  
11/27 NR

12/4 "

12/11 "

12/17 Spud 8-15-52

Oil Well

TD 3554'

8" @ 181

Anhy 1662

DST 3532-54, opn  $\frac{1}{2}$  hr., rec.

110' ho & gcm 930#

3 DST's failed

DST 3542-54 opn  $1\frac{1}{2}$  hr., rec.

480' gas, 80' oil, 20' ho & gcm  
880#

TD 3554

5" @ 3543

Heeb 3240, Tor. 3262, Lans 3280,

DST 3264-88, opn  $\frac{1}{2}$  hr., rec. 9'

mud, VSSO 1080#

B KC 3480, Arb. 3535,

CO to 3554, FU 700' oil

S/down S/2 to 3 inches into  
tank S/7 boph

Comp. 20 bopd

**COMPLETED**

