


Section 15 Township 5 Range 20 W

Well No. # 2 Lappin

Company J. H. Johnson

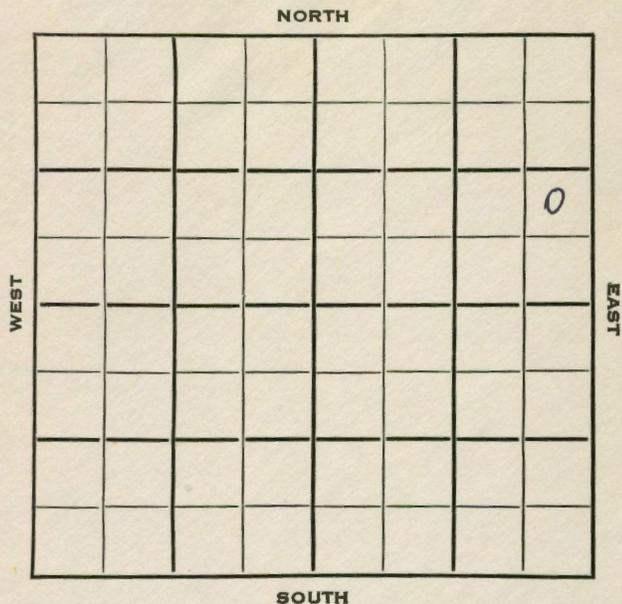

8


SEC. 15 TWP. 5 R. 20 W ✓

WELL NO. # 2 Lappin FARM

COMPANY J. H. Johnson

CONTRACTOR Stern Drlg.

\_\_\_\_\_ Ft. from N. Line  
990 Ft. from S. Line  
330 Ft. from E. Line  
 \_\_\_\_\_ Ft. from W. Line

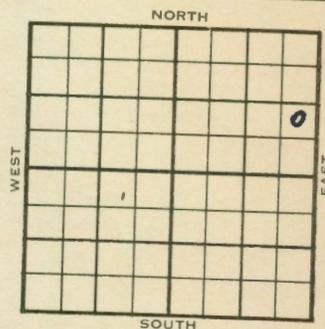

NE SE NE

	ELEVATION	REPORT
1953	<b>2103'</b>	

12/2 Spud 11-24-53  
 8" @ 200 **Anhy 1630'**  
 Drlg. 3353'

12/9 Spud 11-24-53 D & A TD 3537  
 8" @ 200 **Anhy 1630' Heeb 3236**  
**Lans. 3256 Cong. 3519'**  
 DST 3512-23 open 1 hr, rec 75' mud  
 450# TD 3537'  
 D & A

**ABANDONED**

