


Section 16 Township 5 Range 20W

Well No. #1 M. G. Emery

Company Texas Co.

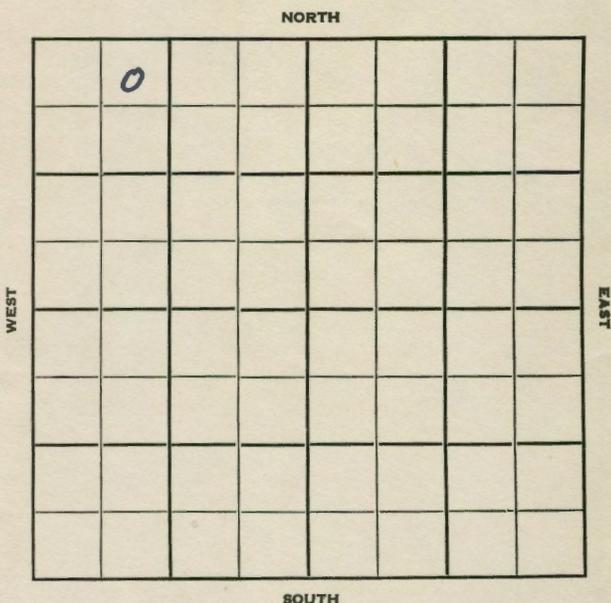

4

Sec. 16 Twp. 5 R. 20W

Well No. #1 M. G. Emery Farm

Texas Co. Company


Wildcat
330' Ft. from N. Line

Ft. from S. Line

Ft. from E. Line

990' Ft. from W. Line

NE NW NW

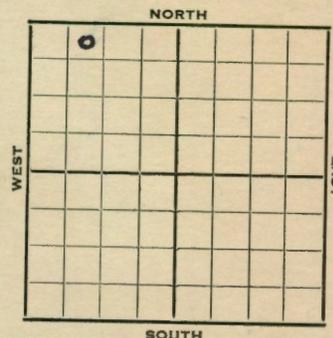

1952 Elev. 2107 REPORT

8/27 Location
 9/3 Drlg. 353'
 9/10 10" @ 353' Topeka 3059' Heeb 3256'
 Tor. 3284'
 DST 3285-3304, 1/2 hr, 5' M O#
 Drlg. 3305'
 9/17 Spud 9-2-52
 D&A TD 3636'
 10" @ 353'
 Top. 3059 Heeb. 3256
 Tor. 3284
 DST 3285-3304' open 1/2 hr. rec. 5' mud
 O# Lans. 3302
 DST 3277-3304 open 1 hr. rec. 10' mud
 470#
 DST 3318-47 open 1 hr. rec. 200'
 mud DST 3340-58 open 1 hr. rec. 105'
 mud, Cong. 3529 Arb. 3581
 TD 3636' D&A

ABANDONED

