


Phillips county

Section 20 Township 5 Range 20-W

Well No. #1, D. G. Hansen

Company Skelly Oil Company

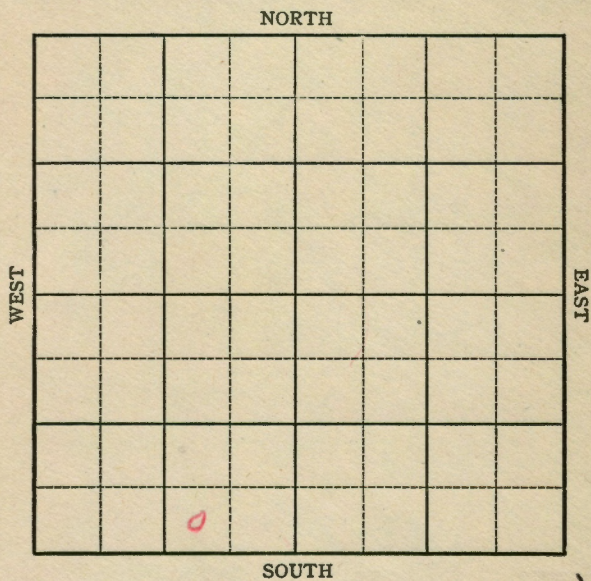

Sec. 20 Twp. 5 R. 20W

Well No. 1 D. G. Hansen Farm

Skelly Company


Hansen

Ft. from N. Line

330 Ft. from S. Line

990 Ft. from E. Line

Ft. from W. Line

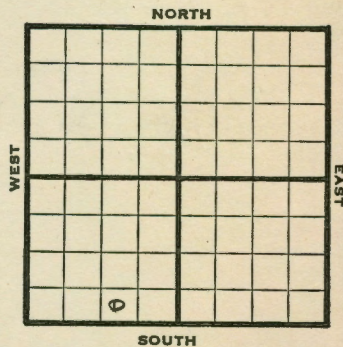

SW SE SW

1946 **Elev. 2177'** REPORT

11/20	RUR
11/27	Drlg 2800' 15" @ 235'
12/3	Lans 3340' TD 3445'
12/10	BKC 3559' Sooy 3598' Arb 3605' TD 3619 SO 5" @ 3613', RUST
12/17	" "
1947	
1/4	Pump 20 oil plus 5 W in 24 hrs 10 qts 3614-18 CO
1/8	Swb 14 oil plus 5 W in 4 hrs.
1/15	500Acid Swb 23 oil & W in 10 hrs
2/21	" " "
1/30	" " "

OVER

2/12 Arb. 3605
5" @ 3613'
Reagan 3617'
Pump 90 oil to 3 W
Pot
Grav. 30
TD 3619'

COMPLETED

KANSAS

Map No. 133 Sec. 20 Twp. 5 R. 20W

Well No. 1 D. G. Hansen

Skelly Company

COMPLETE Contractor

SW SE SW

E 12/97
SECTION PLAT

Ft. from N. Line

330 Ft. from S. Line

990 Ft. from E. Line

Ft. from W. Line

Phillips County

Location _____

Rig up _____

Drilling and Remarks:

2283605
5-203613
Reaper 3617
Produce 90 oil 73W
ST

RECORD

Cased _____ in., _____ ft.

Sand _____

Gas _____

Oil _____

Total Depth 3619

PRODUCTION

1st 24 hrs. Nat. _____

1st 24 hrs. after shot _____

Gas _____ Cu. Ft.

Dry Hole _____

Abandoned _____

Date

FEB 12 1947 19

S. J. LEWIS Scout

KANSAS

Map No. 133 Sec. 20 Twp. 5 R. 20W

Well No. 1 D. G. Hansen

Skelly Company

FIRST REPORT Contractor

SW SE SW

SECTION PLAT

Ft. from N. Line

330 Ft. from S. Line

990 Ft. from E. Line

Ft. from W. Line

Phillips County

Location _____

Rig up _____

Drilling and Remarks:

R U R

RECORD

Cased _____ in., _____ ft.

Sand _____

Gas _____

Oil _____

Total Depth _____

PRODUCTION

1st 24 hrs. Nat. _____

1st 24 hrs. after shot _____

Gas _____ Cu. Ft.

Dry Hole _____

Abandoned _____

Date

NOV 20 1946 19

S. J. LEWIS Scout