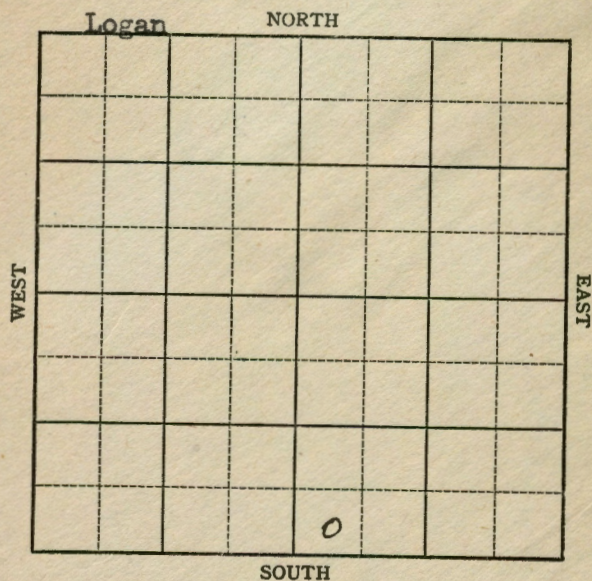


Phillips

KANSAS

Section 20 Township 5 Range 20WWell No. 1 StatesCompany D. G. Hansen

15

KANSAS

Phillips county


Sec. 20 Twp. 5 R. 20WWell No. 1 States Farm
D. G. Hansen Company

Logan Pool

Ft. from N. Line

330 Ft. from S. Line

Ft. from E. Line

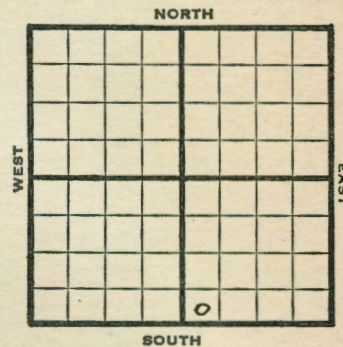330 Ft. from W. Line

SW SE

1947 **Elev. 2167'** REPORT

5/7	RUR		
5/13	10" @ 190'		
	Drlg. 3000'		
5/20	Lans 3323		
	Arb 3580		
	TD 3583'		
	5" @ 3581'		
	RUST		
5/27	" "		
6/3	TD 3592 $\frac{1}{2}$ -		
	1000 and swt 10 bbl oil 1 hr.		
6/10	" "	"	"
6/17	" "	"	"
6/24	" "	"	"
7/1	" "	"	"
7/8	" "	"	"
7-16	" "	"	"
7/22	" "	"	"

1947

7/29 TD 3592 $\frac{1}{2}$ '

8/6 "

8/13 "

8/20 Pump 12 bbls oil PH, 10 hrs.

8/27 "

9/3 "

9/10 "

9/17 "

9/24 "

10/1 "

10/8 "

10/15 Arbuckle 3580

5" @ 3581'

1000 acid

Pump 240 Pot.

YF 3592 $\frac{1}{2}$

Gravity 28

COMPLETED

Map No. 133 Sec. 20 Twp. 5 R. 20WWell No. 1 States

D. G. Hansen Company

COMPLETE Contractor

SW SE

SECTION PLAT

Ft. from N. Line

330 Ft. from S. Line

Ft. from E. Line

330 Ft. from W. Line

Phillips County

Location

Rig up

Drilling and Remarks:


RECORD

Cased in, ft.

Sand

Gas

Oil


PRODUCTION

1st 24 hrs. Nat.

1st 24 hrs. after shot

Gas Cu. Ft.

Dry Hole

Abandoned

Date

OCT 15 1947 19 S. J. LEWIS Scout

Map No. K133 Sec. 20 Twp. 5 R. 20WWell No. 1 States

D. G. Hansen Company

FIRST REPORT

Contractor

SW SE

SECTION PLAT

Ft. from N. Line

330 Ft. from S. Line

Ft. from E. Line

330 Ft. from W. Line

Phillips County

Location

Rig up

Drilling and Remarks:

R U R

RECORD

Cased in, ft.

Sand

Gas

Oil

Total Depth

PRODUCTION

1st 24 hrs. Nat.

1st 24 hrs. after shot

Gas Cu. Ft.

Dry Hole

Abandoned

Date

MAY 7 1947 19 S. J. LEWIS Scout