

Sec. 20 Twp. 5 R. 20-W

Section 20 Township 5 Range 20-W


Well No. 3 States Farm

Well No. # 3 States

D. G. Hansen Company

Company D. G. Hansen

Logan NORTH

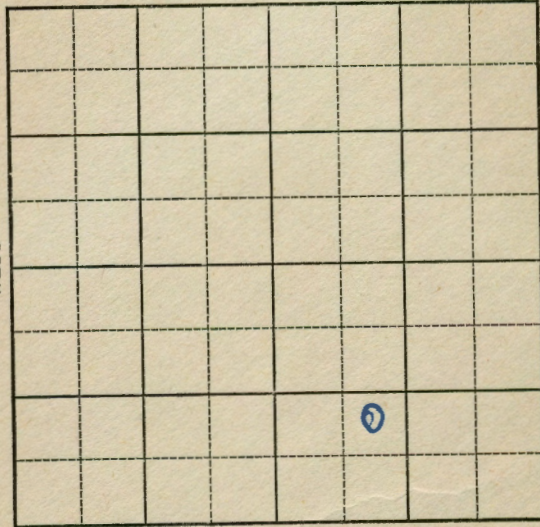

SOUTH

15

Logan Pool


Ft. from N. Line

990 Ft. from S. Line

Ft. from E. Line

990 Ft. from W. Line

NE SW SE

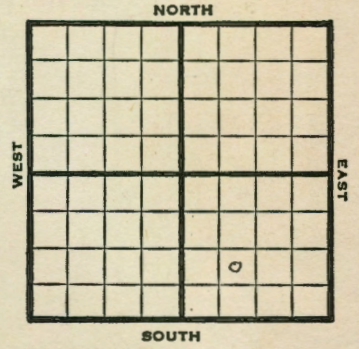

1947 Elev. 2215 REPORT

- 8/20 8" @ 213
Drlg. 215
- 8/27 Drlg. 3060'
- 9/3 Lansing 3377
Arbuckle 3632-35
TD 5" @ 3633 Rust
- 9/10 TD 3650'
1500 Acid
- 9/17 "
- 9/24 Water Squeeze.
- 10/1 Perf 3632'
TD 3650'
5" @ 3633'

ABANDONED

Map No. 133 Sec. 20 Twp. 5 R. 20W

Well No. 3 States

D. G. Hansen Company

ABANDONED Contractor

NE SW SE

SECTION PLAT

 Ft. from N. Line

990 Ft. from S. Line

 Ft. from E. Line

990 Ft. from W. Line

| | | | |
|--|--|--|--|
| | | | |
| | | | |
| | | | |
| | | | |

Phillips County

Location _____

Rig up _____

Drilling and Remarks:

Aug 30 1947
5" @ 215

RECORD

Cased _____ in., _____ ft.

Sand _____

Gas _____

Oil _____

Total Depth 2650

PRODUCTION

1st 24 hrs. Nat. _____

1st 24 hrs. after shot _____

Gas _____ Cu. Ft.

Dry Hole _____

Abandoned _____

Date

OCT 1 1947

S. J. LEWIS Scout

Map No. _____ Sec. 20 Twp. 5 R. 20W

Well No. 3 States

D. G. Hansen Company

FIRST REPORT Contractor

NE SW SE

SECTION PLAT

 Ft. from N. Line

990 Ft. from S. Line

 Ft. from E. Line

990 Ft. from W. Line

| | | | |
|--|--|--|--|
| | | | |
| | | | |
| | | | |
| | | | |

Phillips County

Location _____

Rig up _____

Drilling and Remarks:

8" @ 213

drlg. 215

RECORD

Cased _____ in., _____ ft.

Sand _____

Gas _____

Oil _____

Total Depth _____

PRODUCTION

1st 24 hrs. Nat. _____

1st 24 hrs. after shot _____

Gas _____ Cu. Ft.

Dry Hole _____

Abandoned _____

Date

AUG 20 1947

S. J. LEWIS Scout