



Section 20 Township 5 Range 2 ON
 Well No. 4 States
 Company D. G. Hansen

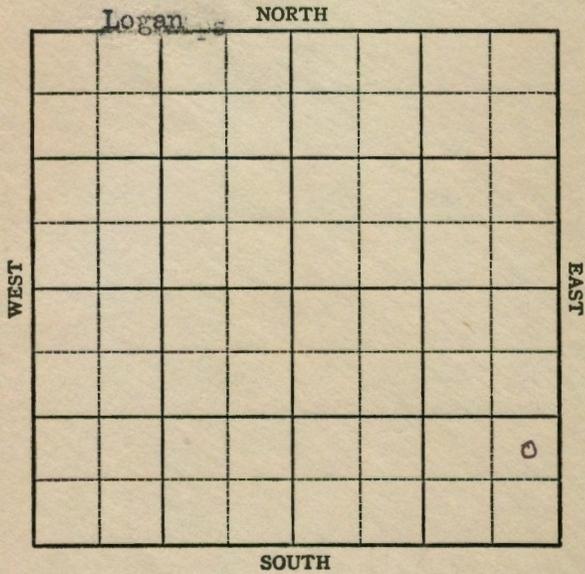

16

Sec. 20 Twp. 5 R. 20-W
 Well No. 4 States Farm
D. G. Hansen Company

Logan Pool
 _____ Ft. from N. Line
990 Ft. from S. Line
330 Ft. from E. Line
 _____ Ft. from W. Line
 NE SE SE

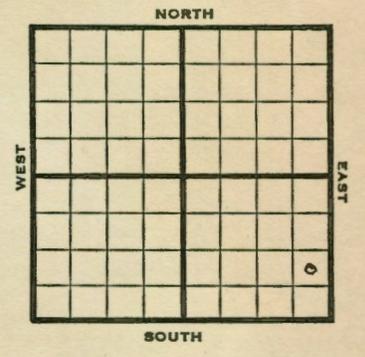

1947	Elev. 2200'	REPORT
9/3	8" @ 216'	Drlg. 220'
9/10		Drlg. 3075'
9/17		"
9/24	Lansing 3382'	Arbuckle 3626'
	Reagan 3630'	TD 3633'
	5" @ 3629'	RUST
10/1	TD 3638'	500 acid.
10/8	Reagan 3630'	5" @ 3629'
		TD 3652½
ABANDONED		

Map No. 133 Sec. 20 Twp. 5 R. 20W

Well No. 4 States

D. G. Hansen Company

ABANDONED Contractor

NE SE SE

E1,2200
SECTION PLAT

 Ft. from N. Line
990 Ft. from S. Line
330 Ft. from E. Line
 Ft. from W. Line

Phillips County

Location _____

Rig up _____

Drilling and Remarks:

*Logan 360
5-1-3628*

RECORD

Cased _____ in., _____ ft.
Sand _____
Gas _____
Oil _____
Total Depth 8628

PRODUCTION

1st 24 hrs. Nat. _____
1st 24 hrs. after shot _____
Gas _____ Cu. Ft.
Dry Hole _____
Abandoned _____

Date

OCT 8 1947 19 S. J. LEWIS Scout

Map No. _____ Sec. 20 Twp. 5 R. 20W

Well No. 4 States

D. G. Hansen Company

FIRST REPORT Contractor

NE SE SE

SECTION PLAT

 Ft. from N. Line
990 Ft. from S. Line
330 Ft. from E. Line
 Ft. from W. Line

Phillips County

Location _____

Rig up _____

Drilling and Remarks:

8" @ 216
drlg. 220

RECORD

Cased _____ in., _____ ft.
Sand _____
Gas _____
Oil _____
Total Depth _____

PRODUCTION

1st 24 hrs. Nat. _____
1st 24 hrs. after shot _____
Gas _____ Cu. Ft.
Dry Hole _____
Abandoned _____

Date

SEP 3 1947 19 S. J. LEWIS Scout